

**SURVEY & REMONUMENTATION**

**FEB 26 1998**

**SECTION**

**LAND CORNER RECORDATION CERTIFICATE**  
Filing Requirement of Act 74, Mich. P.A. 1970

For corners in

Leelanau  
(County)

Located In: Corner Code #

- |                                    |                             |            |
|------------------------------------|-----------------------------|------------|
| 1. Public Land Survey              | T <u>29</u> N R <u>12</u> W | <u>G-3</u> |
|                                    | T ___ R ___                 | _____      |
|                                    | T ___ R ___                 | _____      |
|                                    | T ___ R ___                 | _____      |
| 2. Property Controlling in Section | S ___ T ___ R ___           | _____      |
|                                    | S ___ T ___ R ___           | _____      |
| 3. Miscellaneous Property in Sec.  | S ___ T ___ R ___           | _____      |
|                                    | S ___ T ___ R ___           | _____      |


Barbara Kirt 12/31/97  
Leelanau Res of Deeds 10:24 am  
BJK Fee: 9.00  
04800002 P0241 Page 1 of 1

#544  
Register of Deeds Stamp & File Number

4. Lot No. \_\_\_\_\_, Recorded Plat \_\_\_\_\_  
5. Private Claims \_\_\_\_\_

I, Nicholas M. O'Non, in a field survey on Dec. 4, 1997 do hereby state that under requirements of P.A. 74, Michigan P.A. of 1970, the corner points mentioned in lines 1 and 2 above were in conformance with regulations and rules therefore as required in the current manual of survey instructions of the United States Department of the Interior, Bureau of Land Management or by a decree of a Court of Law and/or that the corner points mentioned in lines 3, 4 and 5 above were in conformance with the rules of the Michigan Board of Land Surveyors or by a Decree of a Court of Law; established, re-established, monumented, recovered, found as expressed below:

NOTE: Not more than 2 corners, all in the same town and range, may be recorded on this certificate.

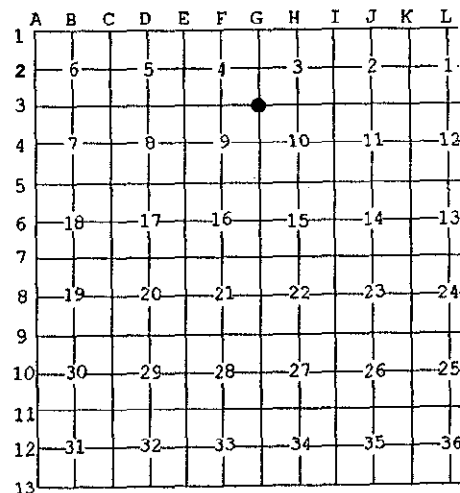

A. Description of original monument and accessories and/or subsequent restoration:

G-3: Section Corner Common To Sections 3, 4, 9 and 10.  
G. L.O. Notes: Set Post Corner To Sections 3, 4, 9 and 10, Nov. 29, 1851  
Beech 8", N39°W, 2 Links  
Beech 8", S39°E, 31 Links

C.P. Tuller: Found Witness Trees, set Stone Corner  
Marked 3, 4, 9 and 10, July 6, 1887.

Stone found by numerous surveyors since 1887.

**APPROVED LAND CORNER**  
**P.A. 345 OF 1990**  
**LEELANAU COUNTY**

DATE: 11-24-97  
COUNTY REP. N.M.O'Non

B. Description of corner evidence found and/or method applied in restoring or reestablishing corner:

G-3: Section Corner Common To Sections 3, 4, 9 and 10.  
Found 1.8'x1.2'x0.5' Stone w/"x" on high point  
and 3, 4, 9 and 10 marked on sides and surrounded  
by 3 black granite stones.

C. Description of monument for corner and accessories established to perpetuate locating the position of the corner:

G-3: Section Corner Common To Sections 3, 4, 9 and 10.  
1.8'x1.2'x0.5' Stone w/"X" and 3, 4, 9 and 10 marked on sides accepted as a careful and faithful perpetuation of the position of the original corner by the Leelanau County Peer Review Group on November 24, 1997. Replace with a 3/4" I.D. by 3.0' long galvanized iron pipe with a stamped brass cap.

9" Maple, N26°E, 15.73'      12" Maple, N13°W, 16.39'  
8" Maple, S58°E, 23.89'      Surrounded by 3 Black Granite Stones  
9" Maple, N58°W, 2.83'

Signed by Nicholas M. O'Non  
Surveyor's Michigan License No. 28420

Date 12-30-97

