

# SURVEY & REMONUMENTATION

FEB 26 1998

## SECTION

## LAND CORNER RECORDATION CERTIFICATE Filing Requirement of Act 74, Mich. P.A. 1970

For corners in

<u>Leelanau</u>	Located In:	Corner Code #
(County)		
1. Public Land Survey	T <u>29NR 12W</u>	<u>G-4 (Centerville Twp.)</u>
	T ___ R ___	_____
	T ___ R ___	_____
	T ___ R ___	_____
2. Property Controlling in Section	S ___ T ___ R ___	_____
	S ___ T ___ R ___	_____
3. Miscellaneous Property in Sec.	S ___ T ___ R ___	_____
	S ___ T ___ R ___	_____

Barbara Kirt 02/04/98  
Leelanau Reg of Deeds 11:28 am  
BJK Fee: 9.00  
04B00002 P0252 Page 1 of 1

#555

Register of Deeds Stamp & File Number

4. Lot No. \_\_\_\_\_, Recorded Plat \_\_\_\_\_  
5. Private Claims \_\_\_\_\_

I, Steven P. Bye, in a field survey on November 27, 1997, do hereby state that under requirements of P.A. 74, Michigan P.A. of 1970, the corner points mentioned in lines 1 and 2 above were in conformance with regulations and rules therefore as required in the current manual of survey instructions of the United States Department of the Interior, Bureau of Land Management or by a decree of a Court of Law and /or that the corner points mentioned in lines 3, 4 and 5 above were in conformance with the rules of the Michigan Board of Land Surveyors or by a Decree of a Court of Law; established, re-established, monumented, recovered, found as expressed below:

	A	B	C	D	E	F	G	H	I	J	K	L	M
1													
2	6		5		4		3		2		1		
3													
4	7		8		9		10		11		12		
5													
6	18		17		16		15		14		13		
7													
8	19		20		21		22		23		24		
9													
10	30		29		28		27		26		25		
11													
12	31		32		33		34		35		36		
13													

**NOTE: Not more than 2 corners, all in the same town and range, may be recorded on this certificate.**

A. Description of original monument and accessories and/or subsequent restoration:

G-4: West 1/4 corner of Section 10

G.L.O. notes: Set 1/4 post at 40.00 chains

Sugar 14 N11W 13 lks.  
Beech 10 S89E 37 lks.

B. Description of corner evidence found and/or method applied in restoring or reestablishing corner:

G-4: West 1/4 corner of Section 10

1981 Harris - found PK nail on centerline and fenceline West  
1985 O'Non - found PK nail and set iron bar w/cap #28420  
Witnesses:  
Power Pole, N29°E, 75.10'  
6" Red Pine, S25°W, 82.58'  
North edge concrete culvert on farm road, marked "x", S69°W 25.71'

**APPROVED LAND CORNER  
P.A. 345 OF 1990  
LEELANAU COUNTY**


DATE: 11-24-97  
COUNTY REP. [Signature]

C. Description of monument for corner and accessories established to perpetuate locating the position of the corner:

G-4: West 1/4 corner of Section 10

Iron with cap #28420 is accepted as best available evidence of the position of the original corner by the Leelanau County Remonumentation Peer Review Group on November 24, 1997 and replaced with a 3/4" galvanized iron pipe 3' long with a brass cap.

Existing Witnesses:	New Witness:
Power Pole N30°E 75.10'	8" poplar S80°W 58.92'
North edge concrete culvert on Farm road S62°W 25.71'	Power Pole N42°W 116.68'

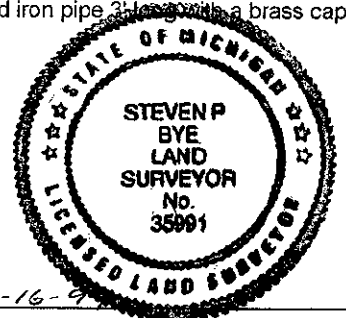

Signed by [Signature: Steven P. Bye]  
Surveyor's Michigan License No. 35991

Date 12-16-97