

**SURVEY &
REMONUMENTATION**

FEB 26 1998

SECTION

**LAND CORNER RECORDATION CERTIFICATE
Filing Requirement of Act 74, Mich. P.A. 1970**

For corners in

Leelanau
(County)

Located In:

Corner Code #

- | | | | |
|---------------------------------------|-------|-------------------|-------------|
| 1. Public Land Survey | | <u>T30N R 11W</u> | <u>E-10</u> |
| | | T ___ R ___ | _____ |
| | | T ___ R ___ | _____ |
| | | T ___ R ___ | _____ |
| 2. Property Controlling
in Section | S ___ | T ___ R ___ | _____ |
| | S ___ | T ___ R ___ | _____ |
| 3. Miscellaneous
Property in Sec. | S ___ | T ___ R ___ | _____ |
| | S ___ | T ___ R ___ | _____ |


Barbara Kirt 12/31/97
Leelanau Reg of Deeds 10:21 am
BJK Fee: 9.00
04800002 P0231 Page 1 of 1

#534
Register of Deeds Stamp & File Number

4. Lot No. _____, Recorded Plat _____
5. Private Claims _____

I, Nicholas M. O'Non, in a field survey on Dec. 2, 1997 do hereby state that under requirements of P.A. 74, Michigan P.A. of 1970, the corner points mentioned in lines 1 and 2 above were in conformance with regulations and rules therefore as required in the current manual of survey instructions of the United States Department of the Interior, Bureau of Land Management or by a decree of a Court of Law and /or that the corner points mentioned in lines 3, 4 and 5 above were in conformance with the rules of the Michigan Board of Land Surveyors or by a Decree of a Court of Law; established, re-established, monumented, recovered, found as expressed below:

NOTE: Not more than 2 corners, all in the same town and range, may be recorded on this certificate.

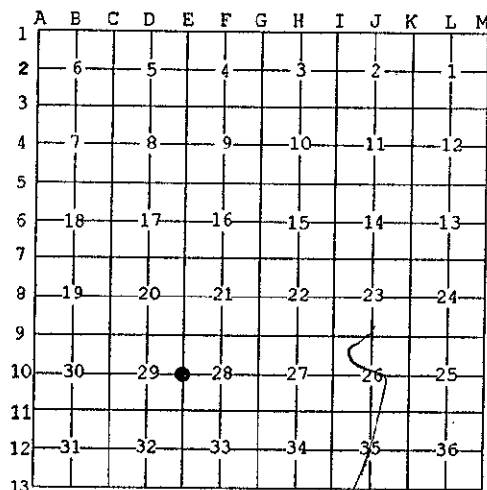

A. Description of original monument and accessories and/or subsequent restoration:

- E-10: 1/4 Corner Common To Section 28 and 29.
G.L.O. Notes: Set 1/4 Section Post, June 7, 1851
Beech 10", N42°W, 8 Links
Hemlock 20", S22°E, 9 Links
H.H. Brehmer: Iron Pipe in concrete inside drain tile about
20" below surface of road, 1940.
15" Maple, N7°E, 42.2'
10" Maple, S35°W, 42.9'

B. Description of corner evidence found and/or method applied in restoring or reestablishing corner:

- E-10: 1/4 Corner Common To Sections 28 and 29
Found 1/2" Iron Pipe below surface of road.
Power Pole, N40°W, 31.32'
Telephone Pole, S10°E, 115.39'
Power Pole, N40°E, 28.32'
8" Cedar, S59°W, 55.82'

**APPROVED LAND CORNER
P.A. 345 OF 1990
LEELANAU COUNTY**

DATE: 12-1-97
COUNTY REP. [Signature]

C. Description of monument for corner and accessories established to perpetuate locating the position of the corner:

- E-10: 1/4 Corner Common To Sections 28 and 29
1/2" Iron Pipe accepted as the best available evidence of the position of the original corner by the Leelanau County Peer Review Group on December 1, 1997. Replaced with a 3/4" I.D. by 3.0' long galvanized iron pipe with stamped brass cap and set in a pavement box.
Power Pole, N40°E, 28.32' 5'± West of Centerline of Elm St. to S
Telephone Pole, S10°E, 115.39' In Centerline of Broadway.
8" Cedar, S59°W, 55.82'
Power Pole, N40°W, 31.32'

Signed by [Signature]
Surveyor's Michigan License No. 28420

Date 12-30-97

