

1994 DEC 30 AM 10:39

Barbara Kirt
REGISTER OF DEEDS

#386

LIBER 2 PAGE 83

Register of Deeds Stamp & File Number

SURVEY & REMONUMENTATION
LAND CORNER RECORDATION CERTIFICATE
Filing Requirement of Act 74, Mich. P.A. 1970

For corners in Leelanau (County) Located In: _____ Corner Code ==

APR 10 1995
COMMISSION

1. Public Land Survey T 30N R 11W E-12
 T _____ R _____
 T _____ R _____
 T _____ R _____
2. Property Controlling in Section S _____ T _____ R _____
 S _____ T _____ R _____
3. Miscellaneous Property in Sec. S _____ T _____ R _____
 S _____ T _____ R _____
4. Lot No. _____, Recorded Plat _____
5. Private Claims _____

	A	B	C	D	E	F	G	H	I	J	K	L	M
2	6	5	4	3	2	1							
3													
4	7	8	9	10	11	12							
5													
6	18	17	16	15	14	13							
7													
8	19	20	21	22	23	24							
9													
10	30	29	28	27	26	25							
11													
12	31	32	33	34	35	36							
13													

I, Nicholas M. O'Non, in a field survey on December 15, 19 94, do hereby certify that under requirements of P.A. 74, Michigan P.A. of 1970, the corner points mentioned in lines 1 and 2 above were in conformance with regulations and rules therefore as required in the current manual of survey instructions of the United States Department of the Interior, Bureau of Land Management or by a decree of a Court of Law and/or that the corner points mentioned in lines 3, 4 and 5 above were in conformance with the rules of the Michigan Board of Land Surveyors or by a Decree of a Court of Law; established, re-established, monumented, re-monumented, recovered, found as expressed below:

NOTE: Not more than 4 corners, all in the same town and range, may be recorded on this certificate.

A. Description of original monument and accessories and/or subsequent restoration:

E-12: 1/4 Corner Common to Sections 32 and 33

G.L.O. Notes: Set 1/4 Post per A.S. Wadsworth Survey June 4, 1851.

Birch 4", N 38° W, 27 Links
Cedar 14", S 47° E, 14 Links

B. Description of corner evidence found and/or method applied in restoring or reestablishing corner:

E-12: 1/4 Corner Common to Sections 32 and 33

Found 5/8" rebar per L.C.R.C. recorded in Liber 1 of corners, page 414.

Power Pole, N 50° W, 25.65'
10" Cedar, S 20° E, 84.65'
4" Poplar, S 30° W, 67.75'

APPROVED LAND CORNER
P. A. 345 OF 1990
LEELANAU COUNTY

DATE: 10-5-94
COUNTY REP. N.M.O'Non


C. Description of monument for corner and accessories established to perpetuate locating the position of the corner:

E-12: 1/4 Corner Common to Sections 32 and 33

Found 5/8" rebar in monument box.

Accepted by the Leelanau County Remonumentation Peer Review Group Oct. 5, 1994. Replaced with 3/4" I.D. galvanized iron pipe 3.0' long with stamped brass cap.

Power Pole, N 50° E, 25.65'
Top Fence Post, N 75° E, 33.98'
10" Cedar, S 20° E, 84.65'
4" Poplar, S 30° W, 67.75'

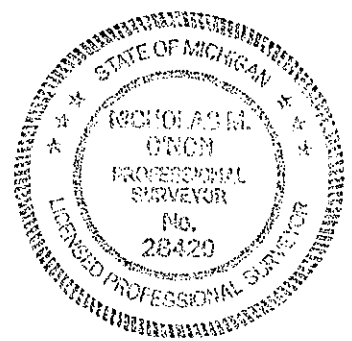

Signed by Nicholas M. O'Non

Date DECEMBER 28, 1994

Surveyor's Michigan License No. 28420

#386