

SURVEY & REMONUMENTATION

STATE OF MICHIGAN
COUNTY OF LEELANAU
RECEIVED FOR RECORD

LAND CORNER RECORDATION CERTIFICATE
Filing Requirement of Act 74, Mich. P.A. 1970

1994 DEC 30 AM 10:41

For corners in APR 10 1995

Leelanau

COMMISSION

Located In:

Corner Code ##

Barbara Kirt
REGISTER OF DEEDS

- | | | |
|------------------------------------|---------------------------|-------------|
| 1. Public Land Survey | T <u>30N</u> R <u>11W</u> | <u>H-13</u> |
| | T _____ R _____ | _____ |
| | T _____ R _____ | _____ |
| | T _____ R _____ | _____ |
| 2. Property Controlling in Section | S _____ T _____ R _____ | _____ |
| | S _____ T _____ R _____ | _____ |
| 3. Miscellaneous Property in Sec. | S _____ T _____ R _____ | _____ |
| | S _____ T _____ R _____ | _____ |

#401

LIBER 2 PAGE 98

Register of Deeds Stamp & File Number

4. Lot No. _____, Recorded Plat _____
5. Private Claims _____

	A	B	C	D	E	F	G	H	I	J	K	L	M
2	6		5		4		3		2		1		
3													
4	7		8		9		10		11		12		
5													
6	18		17		16		15		14		13		
7													
8	19		20		21		22		23		24		
9													
10	30		29		28		27		26		25		
11													
12	31		32		33		34		35		36		
13													

I, Steven P. Bye, in a field survey on December 12, 1994, do hereby certify that under requirements of P.A. 74, Michigan P.A. of 1970, the corner points mentioned in lines 1 and 2 above were in conformance with regulations and rules therefore as required in the current manual of survey instructions of the United States Department of the Interior, Bureau of Land Management or by a decree of a Court of Law and/or that the corner points mentioned in lines 3, 4 and 5 above were in conformance with the rules of the Michigan Board of Land Surveyors or by a Decree of a Court of Law; established, re-established, monumented, re-monumented, recovered, found as expressed below:

NOTE: Not more than 4 corners, all in the same town and range, may be recorded on this certificate.

A. Description of original monument and accessories and/or subsequent restoration:

H-13: South 1/4 corner of Section 34
Brehmer's field notes Book 28, "re-set iron bar at South 1/4 corner on centerline road East & West and North.

B. Description of corner evidence found and/or method applied in restoring or reestablishing corner:

H-13: South 1/4 corner of Section 34
1/2" iron rod found on centerline of McAllister Rd., and two feet West of Centerline of Norvick Rd.

Record witnesses:

- Power pole - N 65 W, 77.91'
- Power pole - S 53 W, 61.73'
- 8" White pine - N 42 E, 92.33'
- 12" Scotch pine - S 04 E, 36.46' (was "red pine")

APPROVED LAND CORNER
P.A. 345 OF 1990
LEELANAU COUNTY

DATE: 10-5-94

COUNTY REP. P. McO'Flon

C. Description of monument for corner and accessories established to perpetuate locating the position of the corner:

H-13: South 1/4 corner of Section 34
1/2" iron rod accepted by the Leelanau County Remonumentation Peer Review Group, October 5, 1994, and replaced with a 3/4" i.d. galvanized iron pipe 3' long with a brass cap and protective monument box.


Witnesses:

- Power pole - N 65 W, 77.91'
- Power pole - S 53 W, 61.73'
- 8" White pine - N 42 E, 92.33'
- 12" Scotch pine - S 04 E, 36.46' (was "red pine")

Signed by Steven P. Bye

Date December 20, 1994

Surveyor's Michigan License No. 35991

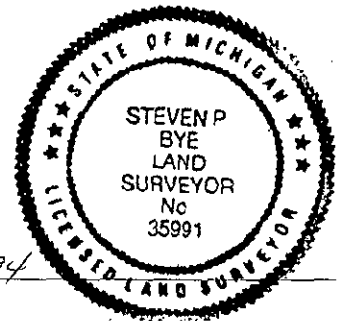

401