

LAND SURVEY & MONUMENTATION
LAND CORNER RECORDATION CERTIFICATE
 REQUIREMENT OF ACT 74, MICH. P.A. 1970

STATE OF MICHIGAN
 COUNTY OF LEELANAU
 RECEIVED FOR RECORD
 1994 DEC 30 AM 10:41

APR 10 1995

FOR CORNERS OF--	LOCATED IN--	CORNER CODE NUMBER
1. PUBLIC LAND SURVEY <u>COMMISSION</u>	T. <u>30</u> N. <u>11</u> E. <u>W.</u>	I-13
2. PROPERTY CONTROLLING IN SECTION	T. _____ S. _____ R. _____ E. _____ W. _____	
3. MISCELLANEOUS PROPERTY IN SECTION	T. _____ S. _____ R. _____ E. _____ W. _____	
4. LOT NO. _____	RECORDED PLAT _____	
5. PRIVATE CLAIMS _____		

Barbara Kirt
 REGISTER OF DEEDS

#403

LIBER 2 PAGE 100

REGISTER OF DEEDS STAMP AND FILING NUMBER

I, Steven P. Bye, do hereby certify that under requirements of P.A. 74, Michigan P.A. of 1970, the corner points mentioned in lines 1 and 2 above were, in a field survey on December 19, 1994, established, re-established, monumented, re-monumented, recovered or restored as expressed below and in conformance with regulations and rules therefore as required in the current manual of survey instructions of the United States Department of the Interior, Bureau of Land Management or by a decree of a court of law. Furthermore, that the corner points mentioned in lines 3, 4 and 5 above were, in a field survey on _____, 19____, found, recovered, restored, established or re-established as expressed below and in conformance with the rules of the Michigan State Board of Registration for Land Surveyors or, by a Decree of a Court of law:

A. Description of original monument and accessories and/or subsequent restoration:

I-13: Southwest corner Section 35.
 GLO Notes: "Set post"
 Sugar 20 N59W 60 links
 Beech 10 N73E 30 links
 Sugar 24 S52W 03 links
 Beech 12 S39E 70 links

APPROVED LAND CORNER
 P.A. 345 OF 1990
 LEELANAU COUNTY
 DATE: 10-5-94
 COUNTY REP. Ke McO'Non

B. Description of corner evidence found and/or method applied in restoring or re-establishing corner:

I-13: Southwest Corner Section 35.
 4" diameter concrete monument found used by numerous surveyors - 14 feet east of centerline north, 5 feet north of centerline west.

Witnesses of record:
 9" Red Pine N25E 44.76'
 Power Pole S80E 25.07'
 10" Red Pine S70W 74.29'
 9" Red Pine N45E 24.74'

C. Description of monument for corner and accessories established to perpetuate locating the position of the corner:

I-13: Southwest corner Section 35.
 4" diameter concrete monument used by numerous surveyors (14' east of centerline north, 5 feet north of centerline west) accepted by the Leelanau County Remonumentation Peer Review Group, October 5, 1994, and replaced with a 3/4" i.d. galvanized iron pipe 3' long with a brass cap and protective monument box.


Existing witnesses:
 Power Pole East 25.08'
 10" Scotch Pine S70W 74.29'
 9" Red Pine N45E 24.74'
 9" Red Pine N25E 44.76'

SIGNED BY Steven P. Bye DATE December 22, 1994
 SURVEYOR'S MICHIGAN REGISTRATION NO. 35991

FOR STATE AND UNITED STATES AGENCIES:

SIGNED BY _____ DATE _____
 CHIEF OF SURVEY PARTY

APPROVED AND SIGNED BY _____ DATE _____
 MICHIGAN REGISTERED LAND SURVEYOR

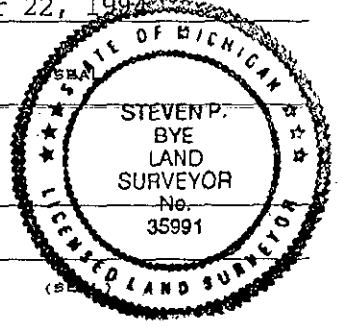

SURVEYOR'S MICHIGAN REGISTRATION NO. _____

#403

MAY PLACE SKETCH ON BACK OR ATTACHED SHEET