

1995 DEC 29 PM 2: 10

LAND CORNER RECORDATION CERTIFICATE
 Filing Requirement of Act 74, Mich. P.A. 1970

For corners in Leelanau (County) Located In: Corner Code #

1. Public Land Survey	T <u>30N</u> R <u>12W</u>	<u>D-11</u>
	T _____ R _____	_____
	T _____ R _____	_____
	T _____ R _____	_____
2. Property Controlling in Section	S _____ T _____ R _____	_____
	S _____ T _____ R _____	_____
3. Miscellaneous Property in Section	S _____ T _____ R _____	_____
	S _____ T _____ R _____	_____

Barbara Kist
 REGISTER OF DEEDS

#437

LIBER 2 PAGE 134

Register of Deeds Stamp & File Number

4. Lot No. _____, Recorded Plat _____
 5. Private Claims _____

I, Victoria A. Brown, in a field survey on December 20, 19 95, do hereby certify that under requirements of P.A. 74, Michigan P.A. of 1970, the corner points mentioned in lines 1 and 2 above were in conformance with regulations and rules therefore as required in the current manual of survey instructions of the United States Department of the Interior, Bureau of Land Management or by a decree of a Court of Law and/or that the corner points mentioned in lines 3, 4 and 5 above were in conformance with the rules of the Michigan Board of Professional Surveyors or by a Decree of a Court of Law; established, re-established, monumented, re-monumented, recovered, found as expressed below:

A	B	C	D	E	F	G	H	I	J	K	L	M
2	6	5	4	3	2	1						
3												
4	7	8	9	10	11	12						
5												
6	18	17	16	15	14	13						
7												
8	19	20	21	22	23	24						
9												
10	30	29	28	27	26	25						
11												
12	31	32	33	34	35	36						
13												

NOTE: Not more than 4 corners, all in the same town and range, may be recorded on this certificate.

A. Description of original monument and accessories and/or subsequent restoration:

D-11: South 1/4 corner - Section 29
 G.L.O. Notes : 40.00' - Set 1/4 section post
 Beech 9 - N 43° E, 15 links
 Beech 9 - S 57° W, 21 links


B. Description of corner evidence found and/or method applied in restoring or reestablishing corner:

D-11: South 1/4 corner - Section 29
 Found 4" x 4" x 4' concrete monument
 Witnesses: 8" oak - S 36° E, 13.96'
 6" oak - North 13.38'
 3" maple - N 60° W, 22.02'

APPROVED LAND CORNER
 P.A. 345 OF 1990
 LEELANAU COUNTY
 DATE: 12-6-95
 COUNTY REP. V. M. O'Neil

C. Description of monument for corner and accessories established to perpetuate locating the position of the corner:

D-11: South 1/4 corner - Section 29
 4"x4" concrete monument accepted as the best available evidence of the position of the original corner by the Leelanau County Remonumentation Peer Review Group, December 6, 1995, and replaced with a 3/4" i.d. galvanized iron pipe 3' long with a brass cap.
 Witnesses: Found spike - 4" red oak - N 05° E, 13.38'
 Set spike - 2" red oak - N 35° E, 14.75'
 Found spike - 11" red oak - S 31 E, 13.98'
 Set spike - 10" ash - S 82° W, 6.00'
 Set spike - 18" red oak - N 21° 30' W, 21.20'

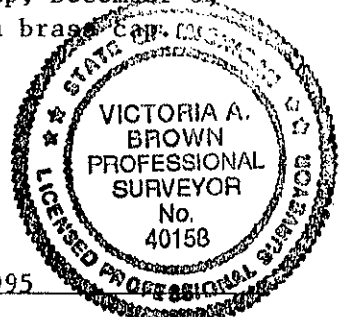

Signed by Victoria A. Brown
 Surveyor's Michigan License No. 40158

Date December 26, 1995