

SURVEY & REMONUMENTATION

APR 28 1995

COMMISSION

LAND CORNER RECORDATION CERTIFICATE
Filing Requirement of Act 74, Mich. P.A. 1970

STATE OF MICHIGAN
COUNTY OF LEELANAU
RECEIVED FOR RECORD

1994 DEC 12 PM 1:41

Barbara Kirt
REGISTER OF DEEDS

#361

LIBER 2 PAGE 58

Register of Deeds Stamp & File Number

For corners in
Leelanau

(County)

Located In:

Corner Code #

1. Public Land Survey	T	30N	R	12W	E-11
	T		R		
	T		R		
	T		R		
2. Property Controlling in Section	S		T	R	
	S		T	R	
3. Miscellaneous Property in Sec.	S		T	R	
	S		T	R	

4. Lot No. _____, Recorded Plat _____
5. Private Claims _____

I, Steven P. Bye, in a field survey on November 10, 19 94, do hereby certify that under requirements of P.A. 74, Michigan P.A. of 1970, the corner points mentioned in lines 1 and 2 above were in conformance with regulations and rules therefore as required in the current manual of survey instructions of the United States Department of the Interior, Bureau of Land Management or by a decree of a Court of Law and/or that the corner points mentioned in lines 3, 4 and 5 above were in conformance with the rules of the Michigan Board of Land Surveyors or by a Decree of a Court of Law; established, re-established, monumented, re-monumented, recovered, found as expressed below:

NOTE: Not more than 4 corners, all in the same town and range, may be recorded on this certificate.

A. Description of original monument and accessories and/or subsequent restoration:


E-11: Northeast corner of Section 32
G.L.O. "Set post corner ~~in~~ Sections 28, 29, 32, & 33"
Beech 6 N 35 E, 20 links
Beech 10 S 32 W, 22 links

County Surveyors notes: Cedar stake
Old Government witness tree 15" beech S 32 W, 14.1'
8" maple N 15 W, 8.4' (marked 13 L)
10" maple North 21.8'

B. Description of corner evidence found and/or method applied in restoring or reestablishing corner:

E-11: Northeast corner of Section 32
5/8" iron rod fitting witnesses as recorded in File #100, Liber 1, Page 197 & 198.

Record witnesses:
16" maple N 20 W, 23.00'
14" maple N 45 W, 8.62'

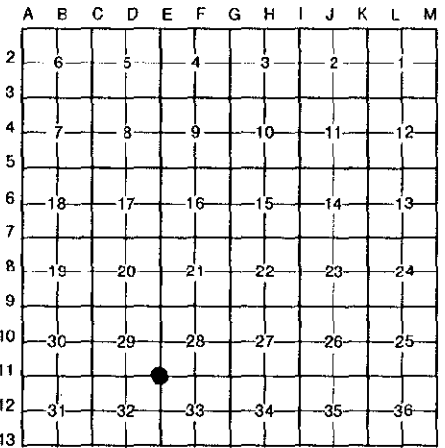


APPROVED LAND CORNER
P.A. 345 OF 1990
LEELANAU COUNTY
DATE: 9-7-94
COUNTY REP. N.M. O'Neil

C. Description of monument for corner and accessories established to perpetuate locating the position of the corner:

E-11: Northeast corner of Section 32
5/8" iron rod accepted by the Leelanau County Remonumentation Peer Review Group, September 7, 1994, and replaced with a 3/4" i.d. galvanized iron pipe 3' long with a brass cap.

16" maple N 03 W, 22.93'
14" maple N 25 W, 8.62'
24" oak North 59.05'
7" oak N 30 E, 38.20'
8" oak S 70 W, 27.24'
14" maple S 70 E, 45.20'

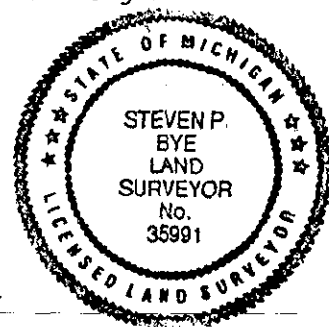

Signed by Steven P. Bye Date November 10, 1994
Surveyor's Michigan License No. 35991