SURVEY &
REMONUMENTATION

APR 28 1995

COMMISSION

STATE OF MICHIGAN
COUNTY OF LEELANAU
RECEIVED FOR RECORD

1994 DEC 12 PM 1:41

Barbara Kirt
REGISTER OF DEEDS

368

LIBER 2 PAGE 65

Register of Deeds Stamp & File Number

LAND CORNER RECORDATION CERTIFICATE

Filing Requirement of Act 74, Mich. P.A. 1970

For corners in Leelanau (County)

	Located In:	Corner Code ##
1. Public Land Survey	T 30N R 12W	E-13
	T ___ R ___	
	T ___ R ___	
	T ___ R ___	
2. Property Controlling	S ___ T ___ R ___	
in Section	S ___ T ___ R ___	
3. Miscellaneous	S ___ T ___ R ___	
Property in Sec.	S ___ T ___ R ___	

4. Lot No. ___, Recorded Plat ___
5. Private Claims ___

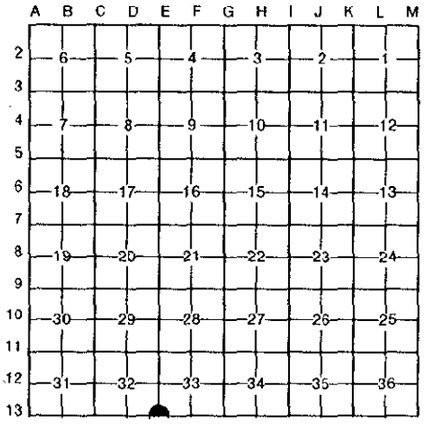

I, Steven P. Bye, in a field survey on November 10, 19 94, do hereby certify that under requirements of P.A. 74, Michigan P.A. of 1970, the corner points mentioned in lines 1 and 2 above were in conformance with regulations and rules therefore as required in the current manual of survey instructions of the United States Department of the Interior, Bureau of Land Management or by a decree of a Court of Law and/or that the corner points mentioned in lines 3, 4 and 5 above were in conformance with the rules of the Michigan Board of Land Surveyors or by a Decree of a Court of Law; established, re-established, monumented, re-monumented, recovered, found as expressed below:

NOTE: Not more than 4 corners, all in the same town and range, may be recorded on this certificate.

A. Description of original monument and accessories and/or subsequent restoration:

E-13: Southwest corner of Section 33
G.L.O. notes "Set post corner to Sections 32 & 33".
Beech 12 N 34 E, 30 links
Beech 12 N 30 W, 22 links

B. Description of corner evidence found and/or method applied in restoring or reestablishing corner:

E-13: Southwest corner of Section 33
1/2" rerod with cap #28417 set by Mitchell, 1987
Record witnesses:
10" ash N 10 E, 16.75'
5/8" rebar N 86 E, 23.62'
12" ash N 56 W, 22.17'
Power pole S 52 W, 71.46'

APPROVED LAND CORNER
P.A. 345 OF 1990
LEELANAU COUNTY
DATE: 9-7-94
COUNTY REP. N. M. O'Neal

C. Description of monument for corner and accessories established to perpetuate locating the position of the corner:

E-13: Southwest corner of Section 33
1/2" rerod with cap #28417 accepted by the Leelanau County Remonumentation Peer Review Group, September 7, 1994, and replaced with a 3/4" i.d. galvanized iron pipe 3' long with a brass cap.
10" ash N 19 E, 16.75'
5/8" rebar N 86 E, 23.62'
12" ash N 55 W, 22.17'
Power pole S 52 W, 71.46'
1/2" rebar West 62.70'

STATE OF MICHIGAN
STEVEN P BYE
LAND SURVEYOR
No. 35991
LICENSED LAND SURVEYOR

Signed by Steven P. Bye Date November 18, 1994

Surveyor's Michigan License No. 35991

FORM APPROVED BY MICHIGAN STATE BOARD OF LAND SURVEYORS, JAN. 28, 1971
REVISED MAY 14, 1975
REVISED JAN., 1983