

1995 DEC 29 PM 2:09

LAND CORNER RECORDATION CERTIFICATE
 Filing Requirement of Act 74, Mich. P.A. 1970

For corners in Leelanau Located In: Corner Code #
(County)

- | | | | | | |
|--------------------------------------|---|------------|---|------------|-------------|
| 1. Public Land Survey | T | <u>30N</u> | R | <u>12W</u> | <u>G-12</u> |
| | T | _____ | R | _____ | _____ |
| | T | _____ | R | _____ | _____ |
| | T | _____ | R | _____ | _____ |
| 2. Property Controlling in Section | S | _____ | T | _____ | R |
| | S | _____ | T | _____ | R |
| 3. Miscellaneous Property in Section | S | _____ | T | _____ | R |
| | S | _____ | T | _____ | R |

Barbara Kist
 REGISTER OF DEEDS

#435

LIBER 2 PAGE 132

Register of Deeds Stamp & File Number

4. Lot No. _____, Recorded Plat _____
 5. Private Claims _____

I, Victoria A. Brown in a field survey on December 21, 19 95, do hereby certify that under requirements of P.A. 74, Michigan P.A. of 1970, the corner points mentioned in lines 1 and 2 above were in conformance with regulations and rules therefore as required in the current manual of survey instructions of the United States Department of the Interior, Bureau of Land Management or by a decree of a Court of Law and/or that the corner points mentioned in lines 3, 4 and 5 above were in conformance with the rules of the Michigan Board of Professional Surveyors or by a Decree of a Court of Law; established, re-established, monumented, re-monumented, recovered, found as expressed below:

A	B	C	D	E	F	G	H	I	J	K	L	M
2	6	5	4	3	2	1						
3												
4	7	8	9	10	11	12						
5												
6	18	17	16	15	14	13						
7												
8	19	20	21	22	23	24						
9												
10	30	29	28	27	26	25						
11												
12	31	32	33	34	35	36						
13												

NOTE: Not more than 4 corners, all in the same town and range, may be recorded on this certificate.

A. Description of original monument and accessories and/or subsequent restoration:

G-12: East 1/4 corner - Section 33
 G.L.O. Notes - 40.00 Set 1/4 section post
 Beech 9 - S 81° E, 10 links
 Beech 12 - S 28° W, 14 links
 December 15, 1851

APPROVED LAND CORNER
 P.A. 345 OF 1990
 LEELANAU COUNTY


DATE: 12-6-95
 COUNTY REP. N.M. O'Non

B. Description of corner evidence found and/or method applied in restoring or reestablishing corner:

G-12: East 1/4 corner - Section 33
 Found 5/8" iron bar in centerline of County Road 645
 Found iron rod 12.60' South of iron bar
 Witnesses: Power pole - S 28° W, 122.11'
 Pine 6" - N 61° W, 51.25'
 Pine 9" - N 79° E, 42.07'
 Pine 4" - S 72° E, 42.42'

C. Description of monument for corner and accessories established to perpetuate locating the position of the corner:

G-12: East 1/4 corner - Section 33
 5/8" iron bar accepted as the best available evidence of the position of the original corner by the Leelanau County Remonumentation Peer Review Group, December 6, 1993, and replaced with a 3/4" i.d. galvanized iron pipe 3' long with a brass cap.
 Witnesses: Spike set - 6" double pine - N 58° E, 50.22'
 1/2" iron rod - South 12.60'
 Easterly garage corner - S 50° W, 66.50'
 Spike re-set, Southwest side 5" red pine - N 35° W, 52.97'

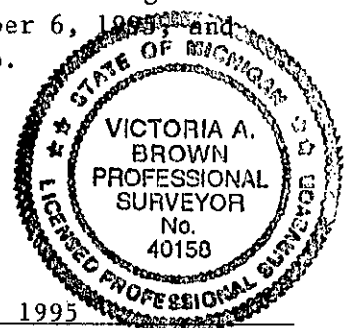

Signed by Victoria A. Brown

Date December 26, 1995

Surveyor's Michigan License No. 40158