

**SURVEY &  
REMONUMENTATION**

MAR 04 1999

**SECTION**

**LAND CORNER RECORDATION CERTIFICATE  
Filing Requirement of Act 74, Mich. P.A. 1970**

For corners in

<u>Leelanau</u> (County)	Located In:	Corner Code #
1. Public Land Survey	T <u>30N R12W</u>	<u>H-7</u>
	T <u>    </u> R <u>    </u>	<u>    </u>
	T <u>    </u> R <u>    </u>	<u>    </u>
	T <u>    </u> R <u>    </u>	<u>    </u>
2. Property Controlling in Section	S <u>    </u> T <u>    </u> R <u>    </u>	<u>    </u>
	S <u>    </u> T <u>    </u> R <u>    </u>	<u>    </u>
3. Miscellaneous Property in Sec.	S <u>    </u> T <u>    </u> R <u>    </u>	<u>    </u>
	S <u>    </u> T <u>    </u> R <u>    </u>	<u>    </u>

Barbara Kirt 12/31/98  
Leelanau Reg of Deeds 1:20 pm  
BJK Fee: 9.00  
04800002 P0310 Page 1 of 1

#613

Register of Deeds Stamp & File Number

4. Lot No. \_\_\_\_\_, Recorded Plat \_\_\_\_\_  
5. Private Claims \_\_\_\_\_


I, Nicholas M. O'Non, in a field survey on December 28, 1998 do hereby state that under requirements of P.A. 74, Michigan P.A. of 1970, the corner points mentioned in lines 1 and 2 above were in conformance with regulations and rules therefore as required in the current manual of survey instructions of the United States Department of the Interior, Bureau of Land Management or by a decree of a Court of Law and /or that the corner points mentioned in lines 3, 4 and 5 above were in conformance with the rules of the Michigan Board of Land Surveyors or by a Decree of a Court of Law, established, re-established, monumented, recovered, found as expressed below:

**NOTE: Not more than 2 corners, all in the same town and range, may be recorded on this certificate.**


A. Description of original monument and accessories and/or subsequent restoration:  
H-7: 1/4 Corner Common to Sections 15 and 22.  
G.L.O. notes: Set 1/4 section post, December 18, 1851.  
Beech 14", N70°W, 11 links  
Beech 14", S32°E, 33 links  
H. H. Brehmer - 1940's - Found iron pipe in concrete.

B. Description of corner evidence found and/or method applied in restoring or reestablishing corner:  
H-7: 1/4 Corner Common to sections 15 and 22.  
Found 1" iron pipe (well point) in concrete.  
Witnesses:  
Power Pole, N71°E, 7.28'  
6" Red Pine, S04°E, 15.55'  
12" Scotch Pine, S85°W, 28.54'  
Apple, N36°W, 74.65'

C. Description of monument for corner and accessories established to perpetuate locating the position of the corner:  
H-7: 1/4 Corner Common to Sections 15 & 22.  
1" iron pipe (well point) accepted as the best available evidence of the position of the original corner by the Leelanau County Remonumentation Peer Review Group on December 16, 1998 and replaced with a 3/4" i.d. x 3.0' long galvanized iron pipe with a stamped brass cap.  
Witnesses:  
Power Pole, N71°E, 7.28'                      8" Balsam, S50°W, 36.69'  
6" Red Pine, S04°E, 15.60'  
6" Red Pine, S43°E, 6.18'  
Apple, N36°W, 74.65'

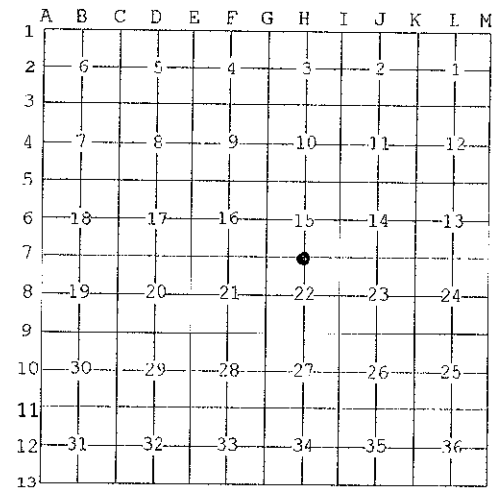

**APPROVED LAND CORNER  
P.A. 345 OF 1990  
LEELANAU COUNTY  
DATE: 12-16-98  
COUNTY REP. N.M.O'N**

 

Signed by Nicholas M. O'Non  
Surveyor's Michigan License No. 28420

Date 12/30/98