

1993

COMMISSION

LAND CORNER RECORDATION CERTIFICATE
Filing Requirement of Act 74, Mich. P.A. 1970

STATE OF MICHIGAN
COUNTY OF LEELANAU
RECEIVED FOR RECORD

1993 DEC 28 PM 4: 24

Barbara Kirt
REGISTER OF DEEDS

FILE #317

LIBER 2 PAGE 14

Register of Deeds Stamp & File Number

For corners in

Leelanau

(County)

Located In:

Corner Code #

- | | | |
|---------------------------------------|---------------------------|-------------|
| 1. Public Land Survey | T <u>30N</u> R <u>12W</u> | <u>H-13</u> |
| | T _____ R _____ | _____ |
| | T _____ R _____ | _____ |
| | T _____ R _____ | _____ |
| 2. Property Controlling in Section | S _____ T _____ R _____ | _____ |
| | S _____ T _____ R _____ | _____ |
| 3. Miscellaneous Property in Sec. | S _____ T _____ R _____ | _____ |
| | S _____ T _____ R _____ | _____ |
| 4. Lot No. _____, Recorded Plat _____ | | |
| 5. Private Claims _____ | | |

	A	B	C	D	E	F	G	H	I	J	K	L	M
2	6		5		4		3		2		1		
3													
4	7		8		9		10		11		12		
5													
6	18		17		16		15		14		13		
7													
8	19		20		21		22		23		24		
9													
10	30		29		28		27		26		25		
11													
12	31		32		33		34		35		36		
13													

I, Steven P. Bye, in a field survey on December 17, 19 93, do hereby certify that under requirements of P.A. 74, Michigan P.A. of 1970, the corner points mentioned in lines 1 and 2 above were in conformance with regulations and rules therefore as required in the current manual of survey instructions of the United States Department of the Interior, Bureau of Land Management or by a decree of a Court of Law and/or that the corner points mentioned in lines 3, 4 and 5 above were in conformance with the rules of the Michigan Board of Land Surveyors or by a Decree of a Court of Law; established, re-established, monumented, re-monumented, recovered, found as expressed below:

NOTE: Not more than 4 corners, all in the same town and range, may be recorded on this certificate.

A. Description of original monument and accessories and/or subsequent restoration:

H-13: S 1/4 corner, Section 34: G.L.O. "Set 1/4 section post"
Beech 9 - S 58 E, 15 links
Beech 14 - S 34 W, 25 links

B. Description of corner evidence found and/or method applied in restoring or reestablishing corner:

H-13: S 1/4 corner, Section 34: Found 5/8" iron rod with cap #19846 83.16' East of the N 1/4 corner of Section 3, T29N, R12W, (SEE FILE #217)


Existing witnesses:

- 8" Maple - S 25 E, 17.55'
- 6" Maple - N 60 E, 5.10'
- Section 3 N 1/4 corner - granite stone with peak - West 83.16' (T29N, R12W)
- 7" Maple - S 80 E, 34.90'
- 8" Ash - N 60 E, 18.60'

C. Description of monument for corner and accessories established to perpetuate locating the position of the corner:

H-13: S 1/4 corner, Section 34: 5/8" iron rod with cap #19846 accepted by the Leelanau County Remonumentation Peer Group, December 9, 1993, and replaced with a 3/4" i.d. galvanized iron pipe with a brass cap.

- 8" Maple - S 25 E, 17.55'
- 6" Maple - N 60 E, 5.10'
- N 1/4 corner Section 3 - granite stone with peak - West 83.16'
- 7" Maple - S 80 E, 34.90'
- 8" Ash - N 60 E, 18.60'

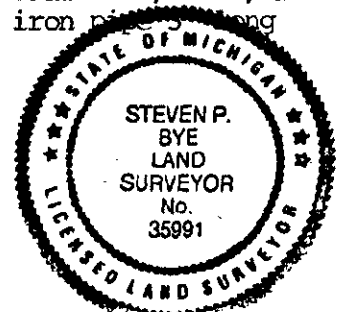

Signed by Steven P. Bye

Date 12-21-93

Surveyor's Michigan License No. 35991