

LAND CORNER RECORDATION CERTIFICATE
 Filing Requirement of Act 74, Mich. P.A. 1970

1995 DEC 29 PM 2: 10

For corners in
Leelanau Located In: Corner Code #
 (County)

Barbara Kirt
 REGISTER OF DEEDS

#436

LIBER 2 PAGE 133

Register of Deeds Stamp & File Number

1. Public Land Survey T 30N R 12W I -13
 T _____ R _____
 T _____ R _____
 T _____ R _____
 2. Property Controlling S _____ T _____ R _____
 in Section S _____ T _____ R _____
 3. Miscellaneous S _____ T _____ R _____
 Property in Section S _____ T _____ R _____

4. Lot No. _____, Recorded Plat _____
 5. Private Claims _____

	A	B	C	D	E	F	G	H	I	J	K	L	M
2	6		5		4		3		2		1		
3													
4	7		8		9		10		11		12		
5													
6	18		17		16		15		14		13		
7													
8	19		20		21		22		23		24		
9													
10	30		29		28		27		26		25		
11													
12	31		32		33		34		35		36		
13													

I, Victoria A. Brown, in a field survey on December 6, 1995, do hereby certify that under requirements of P.A. 74, Michigan P.A. of 1970, the corner points mentioned in lines 1 and 2 above were in conformance with regulations and rules therefore as required in the current manual of survey instructions of the United States Department of the Interior, Bureau of Land Management or by a decree of a Court of Law and/or that the corner points mentioned in lines 3, 4 and 5 above were in conformance with the rules of the Michigan Board of Professional Surveyors or by a Decree of a Court of Law; established, re-established, monumented, re-monumented, recovered, found as expressed below:

NOTE: Not more than 4 corners, all in the same town and range, may be recorded on this certificate.

A. Description of original monument and accessories and/or subsequent restoration:

I-13: Southwest corner - Section 35
 G.L.O. notes: 80.00 set post common to sections 34 & 35
 Beech 9 N 68° E, 23 links
 Beech 9 N 67° W, 8 links

APPROVED LAND CORNER
 P.A. 345 OF 1990
 LEELANAU COUNTY


DATE: 12-6-95
 COUNTY REP. N.M. O'Neil

B. Description of corner evidence found and/or method applied in restoring or reestablishing corner:

I-13: Southwest corner - Section 35
 No evidence of corner at position computed by T. Weinert in 1976 (113.52' East of Northeast corner of Section 3, T29N, R12W)
 Witnesses: Leelanau County Monument - West 113.52' (Northeast corner of Section 3)
 12" Basswood - N 15° E, 28.30'
 10" Double maple - N 50 E, 34.03'

C. Description of monument for corner and accessories established to perpetuate locating the position of the corner:

I-13: Southwest corner - Section 35
 Position of corner at 1.72 chains (113.52') East of the Northeast corner of Section 3, T29N, R12W (recorded - Tuller 1893 and perpetuated by Weinert in 1976) accepted as the best available evidence of the original corner by the Leelanau County Remonumentation Party, Rev. Taylor Group, December 6, 1995 & monumented with a 3/4" i.d. galvanized iron pipe 3' long with brass cap.
 Witnesses: Iron bar and cap #28417 - North 15.64'
 12" Basswood - N 60° E, 55.76'
 Power pole - S 21° W, 102.37'
 8" Maple - N 84° W, 86.91

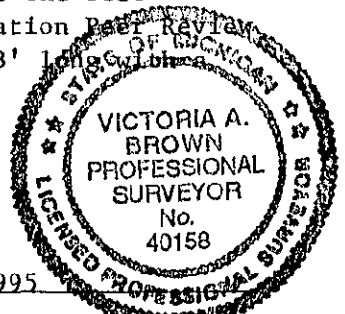

Signed by Victoria A. Brown
 Surveyor's Michigan License No. 40158

Date December 27, 1995