

1995 DEC 29 AM 9:41

LAND CORNER RECORDATION CERTIFICATE

Filing Requirement of Act 74, Mich. P.A. 1970

For corners in Leelanau Located in: _____ Corner Code # _____
 (County)

- | | | | | | |
|--------------------------------------|---|------------|---|------------|-------------|
| 1. Public Land Survey | T | <u>30N</u> | R | <u>12W</u> | <u>J-11</u> |
| | T | _____ | R | _____ | _____ |
| | T | _____ | R | _____ | _____ |
| | T | _____ | R | _____ | _____ |
| 2. Property Controlling in Section | S | _____ | T | _____ | R |
| | S | _____ | T | _____ | R |
| 3. Miscellaneous Property in Section | S | _____ | T | _____ | R |
| | S | _____ | T | _____ | R |

Barbara Kirt
 REGISTER OF DEEDS

#422

LIBER 2 PAGE 119

Register of Deeds Stamp & File Number

4. Lot No. _____, Recorded Plat _____
 5. Private Claims _____

	A	B	C	D	E	F	G	H	I	J	K	L	M
2	6		5		4		3		2		1		
3													
4	7		8		9		10		11		12		
5													
6	18		17		16		15		14		13		
7													
8	19		20		21		22		23		24		
9													
10	30		29		28		27		26		25		
11													
12	31		32		33		34		35		36		
13													

I, Steven P. Bye, in a field survey on December 15, 1995, do hereby certify that under requirements of P.A. 74, Michigan P.A. of 1970, the corner points mentioned in lines 1 and 2 above were in conformance with regulations and rules therefore as required in the current manual of survey instructions of the United States Department of the Interior, Bureau of Land Management or by a decree of a Court of Law and/or that the corner points mentioned in lines 3, 4 and 5 above were in conformance with the rules of the Michigan Board of Professional Surveyors or by a Decree of a Court of Law; established, re-established, monumented, re-monumented, recovered, found as expressed below:

NOTE: Not more than 4 corners, all in the same town and range, may be recorded on this certificate.

A. Description of original monument and accessories and/or subsequent restoration:

J-11: South 1/4 corner of Section 26:
 G.L.O. notes: "set 1/4 section post"
 Beech 16 - N 42° W, 58 lks.
 Sugar 14 - S 47° E, 50 lks.

APPROVED LAND CORNER
 P.A. 345 OF 1990
 LEELANAU COUNTY

DATE: 10-4-95
 COUNTY REP. K.M.O. [Signature]


B. Description of corner evidence found and/or method applied in restoring or reestablishing corner:

J-11: South 1/4 corner of Section 26:
 1/2 reroed with cap #28420 found on centerline Lingaur Road and on fenceline North.
 Record witnesses: 8" Elm - N 07° E, 34.45'
 5" Elm - N 19° W, 40.72'
 1/2" reroed - N 00°23'10" W, 33.00'

C. Description of monument for corner and accessories established to perpetuate locating the position of the corner:

J-11: South 1/4 corner of Section 26:
 1/2" reroed with cap #28420 accepted as the best available evidence of the position of the original corner by the Leelanau County Peer Review Group, December 06, 1995, and replaced with a 3/4" i.d. galvanized iron pipe 3' long with a brass cap and protective monument box.
 Witnesses: 9" Elm - N 07° E, 34.45' 1/2" reroed - N 00°23'10" W, 33.00'
 6" Elm - N 19° W, 40.71' Power pole - N 01° W, 38.13'

Signed by Steven P. Bye
 Surveyor's Michigan License No. 35991

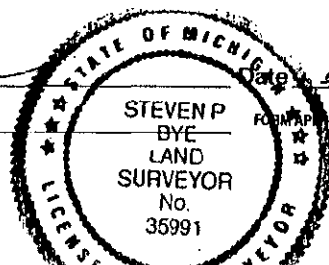

Dec. 19, 1995
 FORM APPROVED BY MICHIGAN STATE BOARD OF PROFESSIONAL SURVEYORS, JAN. 28, 1971
 REVISED MAY 14, 1975
 REVISED JAN., 1983