

1995 DEC 29 AM 9:40

LAND CORNER RECORDATION CERTIFICATE  
Filing Requirement of Act 74, Mich. P.A. 1970

For corners in Leelanau Located In: Corner Code #  
(County)

- 1. Public Land Survey T 31N R 11W C-2  
T \_\_\_\_\_ R \_\_\_\_\_  
T \_\_\_\_\_ R \_\_\_\_\_  
T \_\_\_\_\_ R \_\_\_\_\_
- 2. Property Controlling S \_\_\_\_\_ T \_\_\_\_\_ R \_\_\_\_\_  
in Section S \_\_\_\_\_ T \_\_\_\_\_ R \_\_\_\_\_
- 3. Miscellaneous S \_\_\_\_\_ T \_\_\_\_\_ R \_\_\_\_\_  
Property in Section S \_\_\_\_\_ T \_\_\_\_\_ R \_\_\_\_\_
- 4. Lot No. \_\_\_\_\_, Recorded Plat \_\_\_\_\_
- 5. Private Claims \_\_\_\_\_

*Barbara Kest*  
REGISTER OF DEEDS

#417

LIBER 2 PAGE 114

Register of Deeds Stamp & File Number

I, Steven P. Bye, in a field survey on November 29, 19 95, do hereby certify that under requirements of P.A. 74, Michigan P.A. of 1970, the corner points mentioned in lines 1 and 2 above were in conformance with regulations and rules therefore as required in the current manual of survey instructions of the United States Department of the Interior, Bureau of Land Management or by a decree of a Court of Law and/or that the corner points mentioned in lines 3, 4 and 5 above were in conformance with the rules of the Michigan Board of Professional Surveyors or by a Decree of a Court of Law; established, re-established, monumented, re-monumented, recovered, found as expressed below:

A	B	C	D	E	F	G	H	I	J	K	L	M
2	6	•	5	4	3	2						
3												
4	7	8	9	10	11	12						
5												
6	18	17	16	15	14	13						
7												
8	19	20	21	22	23	24						
9												
10	30	29	28	27	26	25						
11												
12	31	32	33	34	35	36						
13												

NOTE: Not more than 4 corners, all in the same town and range, may be recorded on this certificate.

A. Description of original monument and accessories and/or subsequent restoration:

C-2: West 1/4 corner - Section 5:  
G.L.O. notes: Set 1/4 Section Post  
Sugar 15 - N 43° W, 34 lks.  
Ironwood 6 - S 3° E, 25 lks.

County Surveyors Records:

"used fence corner as corner. Set iron pipe. 0.3' Southeast to corner fence post. 10" Maple Southeasterly 45° 12.3 ft.; 18" Maple - S 50° E, 10.95 ft.; 6" Maple - S 80° W, 40.0 ft."

Concrete monument found (R. Harris 1983)

B. Description of corner evidence found and/or method applied in restoring or reestablishing corner:

C-2: West 1/4 corner - Section 5:  
Concrete monument found 0.3' Northwest of fenceline East, West and South.

APPROVED LAND CORNER  
P.A. 345 OF 1990  
LEELANAU COUNTY

DATE: 10-4-95


COUNTY REP. *Heidi Miller*

C. Description of monument for corner and accessories established to perpetuate locating the position of the corner:

C-2: West 1/4 corner - Section 5:

Concrete monument accepted as the best available evidence of the position of the original corner by the Leelanau County Peer Review Group, October 4, 1995 and replaced with a 3/4" i.d. galvanized iron pipe 3' long with a brass cap

Witnesses: 10" Maple - S 45° E, 13.15'  
18" Maple - S 05° E, 11.54'  
14" Twin Maple - S 73° W, 40.24'  
Brace Pole - N 70° E, 10.53'

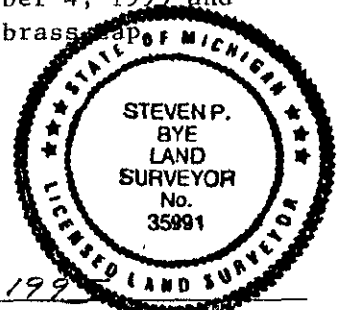

Signed by *Steven P. Bye*  
Surveyor's Michigan License No. 35991

Date DEC. 01, 1995