SURVEY & REMONUMENTATION

1993

COMMISSION

STATE OF MICHIGAN
COUNTY OF LEELANAU
RECEIVED FOR RECORD

1993 DEC 30 PM 4: 17

Barbara Kirt
REGISTER OF DEEDS

FILE #347

LIBER 2 PAGE 44

Register of Deeds Stamp & File Number

LAND CORNER RECORDATION CERTIFICATE

Filing Requirement of Act 74, Mich. P.A. 1970

For corners in

Leelanau (County)

	Located In:	Corner Code #
1. Public Land Survey	T 31 R 11W	C-13
	T ___ R ___	
	T ___ R ___	
	T ___ R ___	
2. Property Controlling	S ___ T ___ R ___	
in Section	S ___ T ___ R ___	
3. Miscellaneous	S ___ T ___ R ___	
Property in Sec.	S ___ T ___ R ___	

4. Lot No. _____ , Recorded Plat _____
5. Private Claims _____

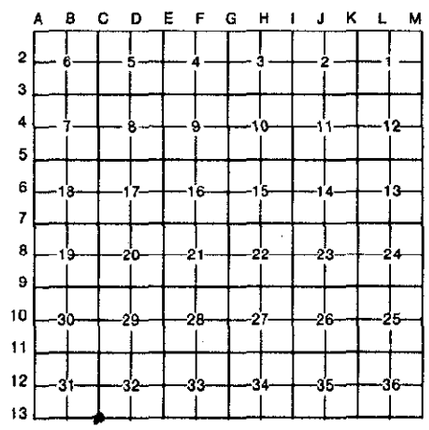

I, Nicholas M. O'Non, in a field survey on December 23, 19 93, do hereby certify that under requirements of P.A. 74, Michigan P.A. of 1970, the corner points mentioned in lines 1 and 2 above were in conformance with regulations and rules therefore as required in the current manual of survey instructions of the United States Department of the Interior, Bureau of Land Management or by a decree of a Court of Law and/or that the corner points mentioned in lines 3, 4 and 5 above were in conformance with the rules of the Michigan Board of Land Surveyors or by a Decree of a Court of Law; established, re-established, monumented, re-monumented, recovered, found as expressed below:

NOTE: Not more than 4 corners, all in the same town and range, may be recorded on this certificate.

A. Description of original monument and accessories and/or subsequent restoration:

C-13: SW Corner Section 32: G.L.O. "Set post corner of Sections 31 & 32 in swamp."
B. Ash 18", N 8° W, 8 links
W. Cedar 14", N 41° W, 10 Links

B. Description of corner evidence found and/or method applied in restoring or reestablishing corner:

C-13: SW Corner Section 32: Found 1/2" iron rod and cap #28420 at base of corner fence post for an East-West fenceline and a fenceline North. Corner had been set in N.M. O'Non Certificate of Survey recorded in Liber 5 of C.S. on pages 218 thru 228.

Existing Witnesses:
5" Balsam Fir, N 61° E, 29.50'
10" Maple, S 57° E, 20.10'

C. Description of monument for corner and accessories established to perpetuate locating the position of the corner:

C-13: SW Corner Section 32: 1/2" iron rod and cap #28420 accepted by Leelanau County Remonumentation Peer Group, December 12, 1993. Replaced with 3/4" I.D. galvonized iron pipe 3.0' long with brass cap.

5" Balsam Fir, N 61° E, 29.56'
10" Maple, S 48° E, 20.03'
5" Maple, N 5° E, 21.18'
10" Maple, S 20° W, 18.75'

Signed by Nicholas M. O'Non Date 12-30-93

Surveyor's Michigan License No. 28420

FORM APPROVED BY MICHIGAN STATE BOARD OF LAND SURVEYORS, JAN. 28, 1971
REVISED MAY 14, 1975
REVISED JAN., 1983