

MAR 15 2000

LAND CORNER RECORDATION CERTIFICATE
Filing Requirement of Act 74, Mich. P.A. 1970

For corners in SECTION

Leelanau (County)	Located In:	Corner Code #
1. Public Land Survey	T 31N R 11W	D-5 (Leelanau)
	T R	
	T R	
	T R	
2. Property Controlling in Section	S T R	
	S T R	
3. Miscellaneous Property in Sec.	S T R	
	S T R	

Barbara Kirt 12/29/99
Leelanau Reg of Deeds 4:11 PM
BJK Fee: 9.00
04800002 P0351 Page 1 of 1

#654


Register of Deeds Stamp & File
Number

4. Lot No. _____, Recorded Plat _____

5. Private Claims _____

I, David T. Rowe, in a field survey on November 23, 1999 do hereby state that under requirements of P.A. 74, Michigan P.A. of 1970, the corner points mentioned in lines 1 and 2 above were in conformance with regulations and rules therefore as required in the current manual of survey instructions of the United States Department of the Interior, Bureau of Land Management or by a decree of a Court of Law and /or that the corner points mentioned in lines 3, 4 and 5 above were in conformance with the rules of the Michigan Board of Land Surveyors or by a Decree of a Court of Law; established, re-established, monumented, recovered, found as expressed below:

NOTE: Not more than 2 corners, all in the same town and range, may be recorded on this certificate.

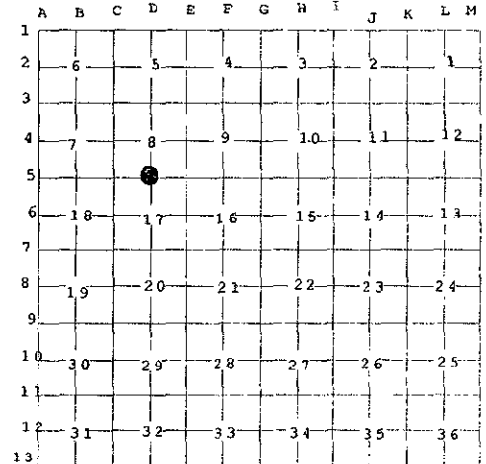

A. Description of original monument and accessories and/or subsequent restoration:

D-5: ¼ Corner Common to Sections 8 and 17:

G.L.D. Notes: 1851 Set ¼ Section Post. 8" Beech N5°E 19 lks., 16" Beech S52°W 9 lks.

County Records: 1996 N. O'Non, Fd. ½" iron pipe. P. Pole N42°E 89.95', 6" Maple S65°E 23.92', 12" Maple S02°E 19.79', P. Pole N46°W 63.49'.

1996 N. O'Non, Same.

1997 N. O'Non, Same. Added witnesses ½" iron rod with cap # 28420 South 14.64', P.K. Nail North 22.31'.

B. Description of corner evidence found and/or method applied in restoring or reestablishing corner:

D-5: ¼ Corner Common to Sections 8 and 17:

Fd. ½" iron pipe on S. edge of paved shoulder M-22.

APPROVED LAND CORNER
P. A. 345 OF 1990
LEELANAU COUNTY

DATE: 11-30-99
COUNTY REP. [Signature]


C. Description of monument for corner and accessories established to perpetuate locating the position of the corner:

D-5: ¼ Corner Common to Sections 8 and 17:

Found ½" iron pipe accepted as a careful and faithful re-establishment of the position of the original corner by the Leelanau County Peer Group, November 30, 1999 and replaced with ¾" i.d. galvanized 36" long iron pipe with a stamped brass cap in monument box.

Witnesses:

- S05°W 19.98' Set Nail W. Face of found Blazed 12" Maple
- S75°E 42.94' Set Nail NE. Face of found Blazed 24" Maple
- N50°W 63.45' Fd. Spike SW. Face 12 P. Pole
- N36°E 89.97' Fd. P.K. Nail SE. Face P. Pole
- S08°W 14.63' Fd. # 28420 Capped Re-Rod

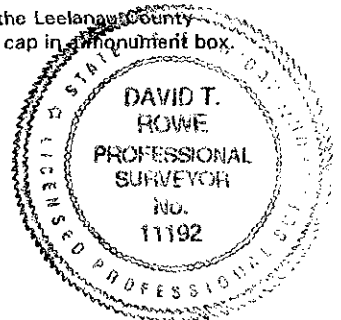

Signed by David T. Rowe
Surveyor's Michigan License No. 11192

Date DEC 22, 1999