

1993

COMMISSION

LAND CORNER RECORDATION CERTIFICATE
Filing Requirement of Act 74, Mich. P.A. 1970

STATE OF MICHIGAN
COUNTY OF LEELANAU
RECEIVED FOR RECORD

1993 DEC 30 PM 4:17

Barbara Kirt
REGISTER OF DEEDS

FILE #348

LIBER 2 PAGE 45

Register of Deeds Stamp & File Number

For corners in

<u>Leelanau</u> (County)	Located In:	Corner Code #
1. Public Land Survey	T <u>31</u> R <u>11W</u>	<u>D-13</u>
	T _____ R _____	_____
	T _____ R _____	_____
	T _____ R _____	_____
2. Property Controlling in Section	S _____ T _____ R _____	_____
	S _____ T _____ R _____	_____
3. Miscellaneous Property in Sec.	S _____ T _____ R _____	_____
	S _____ T _____ R _____	_____
4. Lot No. _____, Recorded Plat _____		
5. Private Claims _____		

A	B	C	D	E	F	G	H	I	J	K	L	M
2	6	5	4	3	2	1						
3												
4	7	8	9	10	11	12						
5												
6	18	17	16	15	14	13						
7												
8	19	20	21	22	23	24						
9												
10	30	29	28	27	26	25						
11												
12	31	32	33	34	35	36						
13												

I, Nicholas M. O'Non, in a field survey on December 23, 19 93, do hereby certify that under requirements of P.A. 74, Michigan P.A. of 1970, the corner points mentioned in lines 1 and 2 above were in conformance with regulations and rules therefore as required in the current manual of survey instructions of the United States Department of the Interior, Bureau of Land Management or by a decree of a Court of Law and/or that the corner points mentioned in lines 3, 4 and 5 above were in conformance with the rules of the Michigan Board of Land Surveyors or by a Decree of a Court of Law; established, re-established, monumented, re-monumented, recovered, found as expressed below:

NOTE: Not more than 4 corners, all in the same town and range, may be recorded on this certificate.

A. Description of original monument and accessories and/or subsequent restoration:

D-13: South 1/4 Corner Section 32: G.L.O. "Set 1/4 Section post."
Beech 18", N 1° W, 17 Links
Sugar 13", N 85° W, 23 Links.

B. Description of corner evidence found and/or method applied in restoring or reestablishing corner:

D-13: South 1/4 Corner Section 32: Found 1/2" iron rod and cap #28420 at base of fence corner for a fence line North and a fenceline West. Corner set in N.M. O'Non Certificate of Survey File No. 9205-5SB3011, Feb. 25, 1992.


Existing Witnesses:

- 10" Ash, N 17° W, 3.65'
- 40" Maple, N 40° E, 30.57'
- 26" Maple, N 34° E, 34.09'
- 31" Beech, N 12° E, 59.48'

C. Description of monument for corner and accessories established to perpetuate locating the position of the corner:

D-13: South 1/4 Corner Section 32: 1/2" iron rod and cap #28420 accepted by Leelanau County Remonumentation Peer Group, December 12, 1993. Replaced with 3/4" I.D. galvanized iron pipe 3.0' long with brass cap.

- 10" Ash, N 17° W, 3.65'
- 40" Maple, N 40° E, 30.57'
- 26" Maple, N 34° E, 34.09'
- 31" Beech, N 12° E, 59.48'

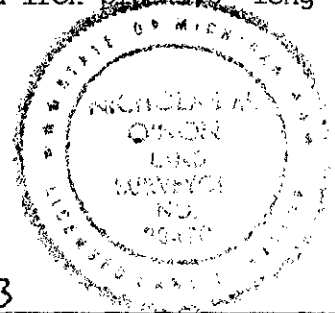

Signed by Nicholas M. O'Non

Date 12-30-93

Surveyor's Michigan License No. 28420