

1995 DEC 29 AM 9:40

**LAND CORNER RECORDATION CERTIFICATE**  
 Filing Requirement of Act 74, Mich. P.A. 1970

For corners in Leelanau (County) Located in: \_\_\_\_\_ Corner Code # \_\_\_\_\_

1. Public Land Survey	T <u>31N</u> R <u>11W</u>	<u>E-2</u>
	T _____ R _____	_____
	T _____ R _____	_____
	T _____ R _____	_____
2. Property Controlling in Section	S _____ T _____ R _____	_____
	S _____ T _____ R _____	_____
3. Miscellaneous Property in Section	S _____ T _____ R _____	_____
	S _____ T _____ R _____	_____

*Barbara Kirt*  
 REGISTER OF DEEDS

#414

LIBER 2 PAGE 111

Register of Deeds Stamp & File Number

4. Lot No. \_\_\_\_\_, Recorded Plat \_\_\_\_\_  
 5. Private Claims \_\_\_\_\_

	A	B	C	D	E	F	G	H	I	J	K	L	M
2	6		5		4		3		2		1		
3													
4	7		8		9		10		11		12		
5													
6	18		17		16		15		14		13		
7													
8	19		20		21		22		23		24		
9													
10	30		29		28		27		26		25		
11													
12	31		32		33		34		35		36		
13													

I, Steven P. Bye, in a field survey on November 22, 1995, do hereby certify that under requirements of P.A. 74, Michigan P.A. of 1970, the corner points mentioned in lines 1 and 2 above were in conformance with regulations and rules therefore as required in the current manual of survey instructions of the United States Department of the Interior, Bureau of Land Management or by a decree of a Court of Law and/or that the corner points mentioned in lines 3, 4 and 5 above were in conformance with the rules of the Michigan Board of Professional Surveyors or by a Decree of a Court of Law; established, re-established, monumented, re-monumented, recovered, found as expressed below:

NOTE: Not more than 4 corners, all in the same town and range, may be recorded on this certificate.

A. Description of original monument and accessories and/or subsequent restoration:

E-2: West 1/4 corner - Section 4:  
 G.L.O. notes: Set 1/4 post  
 Beech 4 - N41W, 11 lks.  
 Beech 10 - S73E, 25 lks.

APPROVED LAND CORNER  
 P.A. 345 OF 1990  
 LEELANAU COUNTY

DATE: 10-4-95  
 COUNTY REP. H. M. O'H

B. Description of corner evidence found and/or method applied in restoring or reestablishing corner:


E-2: West 1/4 corner - Section 4:  
 Weinert found stone with "X" in 1974, and replaced it with a 5/8" iron bar and cap #19846 at corner fenceline North and East.

Weinert witnesses:  
 16" maple N 85° E, 8.95"  
 6" maple S 40° E, 31.69"

C. Description of monument for corner and accessories established to perpetuate locating the position of the corner:

E-2: West 1/4 corner - Section 4:  
 5/8" iron bar and cap #19846 accepted by the Leelanau County Remonumentation Peer Review Group, October 4, 1995, and replaced with a 3/4" i.d. galvanized iron pipe 3' long with a brass cap.

Witnesses: 20" maple East 8.76'  
 12" cherry N 28° W, 44.47'  
 8" cherry S 77° W, 30.75'  
 NW Face 3' x 3' x 2' stone S 58° E, 42.4'

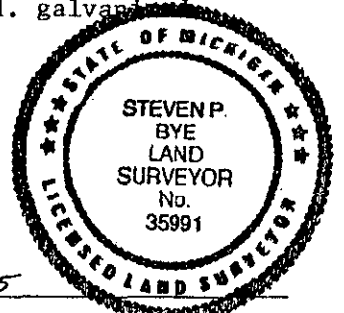

Signed by Steven P. Bye  
 Surveyor's Michigan License No. 35991

Date Nov. 29, 1995