

1995 DEC 29 AM 9:40

LAND CORNER RECORDATION CERTIFICATE
 Filing Requirement of Act 74, Mich. P.A. 1970

For corners in Leelanau (County) Located In: _____ Corner Code # _____

1. Public Land Survey	T	<u>31N</u>	R	<u>11W</u>	E-3
	T	_____	R	_____	_____
	T	_____	R	_____	_____
	T	_____	R	_____	_____
2. Property Controlling in Section	S	_____	T	_____	R
	S	_____	T	_____	R
3. Miscellaneous Property in Section	S	_____	T	_____	R
	S	_____	T	_____	R

Barbara Hirt
 REGISTER OF DEEDS

#415

LIBER 2 PAGE 112

Register of Deeds Stamp & File Number

4. Lot No. _____, Recorded Plat _____
 5. Private Claims _____

A	B	C	D	E	F	G	H	I	J	K	L	M
2	6		5		4		3		2		1	
3				•								
4	7		8		9		10		11		12	
5												
6	18		17		16		15		14		13	
7												
8	19		20		21		22		23		24	
9												
10	30		29		28		27		26		25	
11												
12	31		32		33		34		35		36	
13												

I, Steven P. Bye, in a field survey on November 22, 1995, do hereby certify that under requirements of P.A. 74, Michigan P.A. of 1970, the corner points mentioned in lines 1 and 2 above were in conformance with regulations and rules therefore as required in the current manual of survey instructions of the United States Department of the Interior, Bureau of Land Management or by a decree of a Court of Law and/or that the corner points mentioned in lines 3, 4 and 5 above were in conformance with the rules of the Michigan Board of Professional Surveyors or by a Decree of a Court of Law; established, re-established, monumented, re-monumented, recovered, found as expressed below:

NOTE: Not more than 4 corners, all in the same town and range, may be recorded on this certificate.

A. Description of original monument and accessories and/or subsequent restoration:

E-3: Southwest corner - Section 4:
 G.L.O. notes: Set post corner 4, 5, 8 & 9
 Beech 20 - N 28° W, 22 lks.
 Beech 12 - S 66° E, 39 lks.


APPROVED LAND CORNER
P.A. 345 OF 1990
LEE LANAU COUNTY
 DATE: 10-4-95
 COUNTY REP. M. M. O'Hara

B. Description of corner evidence found and/or method applied in restoring or reestablishing corner:

E-3: Southwest corner - Section 4:
 Found iron bar and cap #10681 on East-West fenceline, on fenceline North and 12' East of fenceline South.

C. Description of monument for corner and accessories established to perpetuate locating the position of the corner:

E-3: Southwest corner - Section 4:
 Iron bar and cap #10681 accepted as the best available evidence of the position of the original corner by the Leelanau County Remonumentation Peer Review Group, October 4, 1995, and replaced with a 3/4" i.d. galvanized iron pipe 3' long with a brass cap.
 Witnesses: 22" Maple - N 89° W, 18.26'
 20" Beech - S 02° E, 29.78'
 12" Maple - S 28° E, 4.42'
 19" Maple - N 44° E, 15.28'

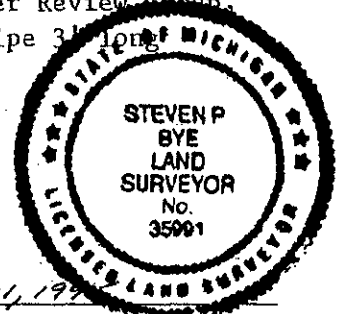

Signed by Steven P. Bye
 Surveyor's Michigan License No. 35991

Date December 01, 1995