

1993

COMMISSION

STATE OF MICHIGAN
COUNTY OF LEELANAU
RECEIVED FOR RECORD

1993 DEC 30 PM 4: 17

LAND CORNER RECORDATION CERTIFICATE
Filing Requirement of Act 74, Mich. P.A. 1970

Barbara Kirt
REGISTER OF DEEDS

FILE #346

LIBER 2 PAGE 43

Register of Deeds Stamp & File Number

For corners in

Leelanau
(County)

Located In:

Corner Code #

- 1. Public Land Survey T 31 R 11 W E-13
- T _____ R _____
- T _____ R _____
- T _____ R _____
- 2. Property Controlling S _____ T _____ R _____
- in Section S _____ T _____ R _____
- 3. Miscellaneous S _____ T _____ R _____
- Property in Sec. S _____ T _____ R _____

- 4. Lot No. _____, Recorded Plat _____
- 5. Private Claims _____

| | A | B | C | D | E | F | G | H | I | J | K | L | M |
|----|----|----|----|----|----|----|---|---|---|---|---|---|---|
| 2 | 6 | 5 | 4 | 3 | 2 | 1 | | | | | | | |
| 3 | | | | | | | | | | | | | |
| 4 | 7 | 8 | 9 | 10 | 11 | 12 | | | | | | | |
| 5 | | | | | | | | | | | | | |
| 6 | 13 | 17 | 16 | 15 | 14 | 13 | | | | | | | |
| 7 | | | | | | | | | | | | | |
| 8 | 19 | 20 | 21 | 22 | 23 | 24 | | | | | | | |
| 9 | | | | | | | | | | | | | |
| 10 | 30 | 29 | 28 | 27 | 26 | 25 | | | | | | | |
| 11 | | | | | | | | | | | | | |
| 12 | 31 | 32 | 33 | 34 | 35 | 36 | | | | | | | |
| 13 | | | | | | | | | | | | | |

I, Nicholas M. O'Non, in a field survey on December 23, 1993, do hereby certify that under requirements of P.A. 74, Michigan P.A. of 1970, the corner points mentioned in lines 1 and 2 above were in conformance with regulations and rules therefore as required in the current manual of survey instructions of the United States Department of the Interior, Bureau of Land Management or by a decree of a Court of Law and/or that the corner points mentioned in lines 3, 4 and 5 above were in conformance with the rules of the Michigan Board of Land Surveyors or by a Decree of a Court of Law; established, re-established, monumented, re-monumented, recovered, found as expressed below:

NOTE: Not more than 4 corners, all in the same town and range, may be recorded on this certificate.

A. Description of original monument and accessories and/or subsequent restoration:

E-13: SE Corner Section 32: G.L.O. "Set post at corners of Sections 32 & 33.
Beech 6", N 84° W, 25 Links.
Ironwood 7", N 17° E, 6 Links

B. Description of corner evidence found and/or method applied in restoring or reestablishing corner:

E-13: SE Corner Section 32: Found 1" diameter iron bar.
Accepted as best available evidence of corner.


Existing Witnesses:

- 8" Apple, S 2° W, 31.30'
- 3" Sweet Cherry, N 67° E, 35.60'
- 8" Sweet Cherry, N 22° E, 36.55'

C. Description of monument for corner and accessories established to perpetuate locating the position of the corner:

EOL3: SE Corner Section 32: 1" diameter iron bar accepted by Leelanau County Remonumentation Peer Group, December 12, 1993.
Replaced with 3/4" I.D. galvanized iron pipe 3.0' long with brass cap.

- 8" Apple, S 2° W, 31.30'
- 3" Sweet Cherry, N 67° E, 35.60'
- 4" Sweet Cheery, N 18° E, 54.80'
- 6" Apple, S 58° E, 67.70'

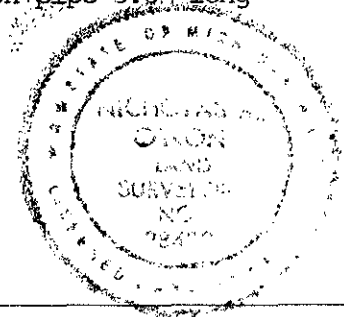

Signed by *Nicholas M. O'Non*

Date 12-30-93

Surveyor's Michigan License No. 28420