

MAR 15 2000

SECTION

LAND CORNER RECORDATION CERTIFICATE
Filing Requirement of Act 74, Mich. P.A. 1970


For corners in

Table with columns: Leelanau (County), Located In: (T 31N R 11W), Corner Code # (G-5 (Leelanau)). Rows include Public Land Survey, Property Controlling in Section, and Miscellaneous Property in Sec.

Barbara Kirt 12/29/99
Leelanau Reg of Deeds 4:10 PM
BJK Feet 9.00
04B00002 P0349 Page 1 of 1
#651
Register of Deeds Stamp & File Number

4. Lot No. , Recorded Plat
5. Private Claims

I, David T. Rowe, in a field survey on November 29, 1999 do hereby state that under requirements of P.A. 74, Michigan P.A. of 1970, the corner points mentioned in lines 1 and 2 above were in conformance with regulations and rules therefore as required in the current manual of survey instructions of the United States Department of the Interior, Bureau of Land Management or by a decree of a Court of Law and /or that the corner points mentioned in lines 3, 4 and 5 above were in conformance with the rules of the Michigan Board of Land Surveyors or by a Decree of a Court of Law; established, re-established, monumented, recovered, found as expressed below:

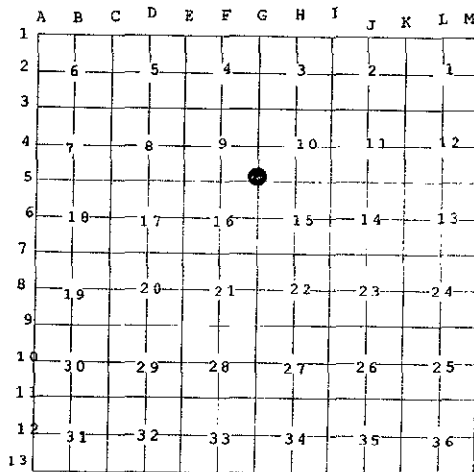

NOTE: Not more than 2 corners, all in the same town and range, may be recorded on this certificate.

A. Description of original monument and accessories and/or subsequent restoration:

- G-5: Corner Common to Sections 9, 10, 15 and 16:
G.L.O. Notes: 1851 Set Post. 26" Birch N36°W 33 lks., 16" Sugar S55°E 18 lks.
County Records: 1930's Survey Book 3, Page 132 shows concrete monument
1989 N. O'Non. Fd. 4" Square Concrete Monument. 26" Maple N88°W 44.50', 30" Maple N56°W 41.25', 9" Maple N12°W 36.36'
1990 J. Korr, Fd. Square Concrete Monument. 30" Maple N57°W 41.32', 28" Maple N88°W 44.53', 8" Maple N11°W 36.24', 12" Poplar S30°E 28.95'.

B. Description of corner evidence found and/or method applied in restoring or reestablishing corner:

G-5: Corner Common to Sections 9, 10, 15 and 16:
Fd. Square Concrete Monument 15' S. of centerline 12' dirt road.


APPROVED LAND CORNER
P.A. 345 OF 1990
LEELANAU COUNTY

DATE: 11-30-99
COUNTY REP. [Signature]

C. Description of monument for corner and accessories established to perpetuate locating the position of the corner:

G-5: Corner Common to Sections 9, 10, 15 and 16:
Found Square Concrete Monument accepted as a careful and faithful re-establishment of the position of the original corner by the Leelanau County Peer Group, November 30, 1999.

- Witnesses:
N81°W 44.78' Fd. Bent Spike S. Face Blazed 24" Maple
S80°W 34.69' Fd. Bent Spike N. Face Clump of 4, 12" Ash
S03°W 60.07' Set Nail E. Face 24" Maple
S27°E 29.04' Fd. Spike NE. Face Blazed 12" Aspen
N07°W 36.29' Fd. Spike SW. Face Blazed 10" Maple

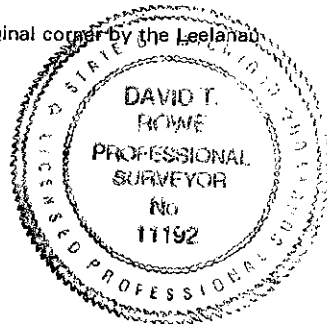

Signed by [Signature]
Surveyor's Michigan License No. 11192

Date Dec 22 1999