

**SURVEY &
REMONUMENTATION**

FEB 26 1998

**LAND CORNER RECORDATION CERTIFICATE
Filing Requirement of Act 74, Mich. P.A. 1970**

For corners **SECTION**

<u>Leelanau</u> (County)	Located In:	Corner Code #
1. Public Land Survey	T <u>31</u> NR <u>11</u> W	<u>G-11</u>
	T ___ R ___	_____
	T ___ R ___	_____
	T ___ R ___	_____
2. Property Controlling in Section	S ___ T ___ R ___	_____
	S ___ T ___ R ___	_____
3. Miscellaneous Property in Sec.	S ___ T ___ R ___	_____
	S ___ T ___ R ___	_____

Barbara Kirt 12/30/97
Leelanau Rec of Deeds 3:13 PM
BJK Fee: 9.00
04B00002 P0219 Page 1 of 1

#522

Register of Deeds Stamp & File Number

4. Lot No. _____, Recorded Plat _____
5. Private Claims _____

I, David T. Rowe, in a field survey on 12-17, 19 97 do hereby state that under requirements of P.A. 74, Michigan P.A. of 1970, the corner points mentioned in lines 1 and 2 above were in conformance with regulations and rules therefore as required in the current manual of survey instructions of the United States Department of the Interior, Bureau of Land Management or by a decree of a Court of Law and/or that the corner points mentioned in lines 3, 4 and 5 above were in conformance with the rules of the Michigan Board of Land Surveyors or by a Decree of a Court of Law; established, re-established, monumented, recovered, found as expressed below:

NOTE: Not more than 2 corners, all in the same town and range, may be recorded on this certificate.

A	B	C	D	E	F	G	H	I	J	K	L	M
1												
2	6		5		4		3		2		1	
3												
4	7		8		9		10		11		12	
5												
6	18		17		16		15		14		13	
7												
8	19		20		21		22		23		24	
9												
10	30		29		28		27		26		25	
11												
12	31		32		33		34		35		36	
13												

A. Description of original monument and accessories and/or subsequent restoration:

G - 11 Corner Common to Sections 27, 28, 33 and 34
G.L.O. notes: Set Post. West Cedar 10" - N59°E, 7 lks., West Cedar 8" 0 S71°W, 6 lks.
County Records: 1893 Greene - found one original witness W. Cedar 10" - N59°E, 7 lks.
Found 1" I. Pipe at base of fence corner (1988 N. 0'Non) 11" Cedar - S50°W, 3.85', 10" Cedar N49°W, 14.85', 8" Cedar - S61°E, 13.96', on fenceline South.
Found 1" I. Pipe, same wit's (N.0'Non: 1988)
Found 1" I. Pipe, same wit's (N.0'Non: 1996)

B. Description of corner evidence found and/or method applied in restoring or reestablishing corner:

G - 11 Corner Common to Sections 27, 28, 33 and 34
Found 1" x 36" I. Pipe at North base of wooden fence post, on fenceline to South.


APPROVED LAND CORNER
P.A. 345 OF 1990
LEELANAU COUNTY

DATE: 12-1-97

COUNTY REP. D. M. O'P

C. Description of monument for corner and accessories established to perpetuate locating the position of the corner:

G - 11 Corner Common to Sections 27, 28, 33 and 34
1" Iron Pipe accepted as the best available evidence of the position of the original corner by the Leelanau County Peer Review Group, 12-1-1997 and replaced with a 3/4" i.d. galvanized Iron Pipe 3' long with a brass cap.
Witnesses: S50°W 3.90' Set nail in N.W. face of found blazed 12" Cedar
N48°W 14.98' Set nail in N.E. face of found blazed 12" Cedar
S62°E 14.02' Set nail in S. face of found blazed 10" Cedar
N05°E 16.29' Set nail in E. face of 14" Tamarack

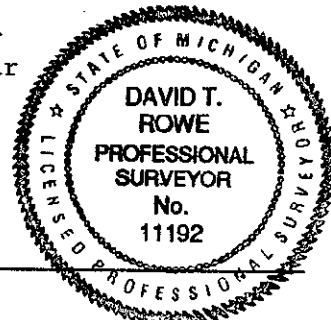

Signed by David T. Rowe
Surveyor's Michigan License No. 11192

Date DEC 13, 1997