

**SURVEY &
REMONUMENTATION CORNER RECORDATION CERTIFICATE**

STATE OF MICHIGAN
COUNTY OF LEELANAU
RECEIVED FOR RECORD

1994 DEC 30 AM 10:40

For corners in

Leelanau
(County)

APR 10 1995

Located In:

Corner Code #

COMMISSION

- | | | |
|---------------------------------------|---------------------------|-------------|
| 1. Public Land Survey | T <u>31N</u> R <u>11W</u> | <u>G-12</u> |
| | T _____ R _____ | _____ |
| | T _____ R _____ | _____ |
| | T _____ R _____ | _____ |
| 2. Property Controlling
in Section | S _____ T _____ R _____ | _____ |
| | S _____ T _____ R _____ | _____ |
| 3. Miscellaneous
Property in Sec. | S _____ T _____ R _____ | _____ |
| | S _____ T _____ R _____ | _____ |

Barbara Hirt
REGISTER OF DEEDS

#392

LIBER 2 PAGE 89

Register of Deeds Stamp & File Number

4. Lot No. _____, Recorded Plat _____
5. Private Claims _____

I, Nicholas M. O'Non, in a field survey on December 13, 19 94, do hereby certify that under requirements of P.A. 74, Michigan P.A. of 1970, the corner points mentioned in lines 1 and 2 above were in conformance with regulations and rules therefore as required in the current manual of survey instructions of the United States Department of the Interior, Bureau of Land Management or by a decree of a Court of Law and/or that the corner points mentioned in lines 3, 4 and 5 above were in conformance with the rules of the Michigan Board of Land Surveyors or by a Decree of a Court of Law; established, re-established, monumented, re-monumented, recovered, found as expressed below:

NOTE: Not more than 4 corners, all in the same town and range, may be recorded on this certificate.

	A	B	C	D	E	F	G	H	I	J	K	L	M
2	6		5		4		3		2		1		
3													
4	7		8		9		10		11		12		
5													
6	16		17		16		15		14		13		
7													
8	19		20		21		22		23		24		
9													
10	30		29		28		27		26		25		
11													
12	31		32		33		34		35		36		
13													

A. Description of original monument and accessories and/or subsequent restoration:

G-12: 1/4 Corner Common to Sections 33 and 34
 G.L.O. Notes: Set 1/4 Section Post
 per A.S. Wadsworth Survey in 1851
 Hemlock 9", N 55° W, 22 Links
 Hemlock 20", S 22° W, 35 Links


B. Description of corner evidence found and/or method applied in restoring or reestablishing corner:

G-12: 1/4 Corner Common to Sections 33 and 34.
 1/2" x 24" rerod with cap no. 28420 set per N.M. O'Non C.S. File No. 8102-33LL3111, Nov. 9, 1981. Witnessed on N.M. O'Non C.S. File No. 8309-33LL3111, June 6, 1983.
 10" White Pine, N 70° E, 20.27'
 14" Norway Pine, S 45° E, 77.52'
 7" Poplar, S 85° W, 3.79'
 At intersection of North-South and East-West Fencelines.

APPROVED LAND CORNER
P. A. 345 OF 1990
LEELANAU COUNTY
 DATE: 10-26-94
 COUNTY REP. N.M.O'Non

C. Description of monument for corner and accessories established to perpetuate locating the position of the corner:

G-12: 1/4 Corner Common to Sections 33 and 34.
 Found 1/2" x 24" rerod with cap no. 28420.
 Approved by Leelanau County Remonumentation Peer Review Group October 26, 1994. Replaced with 3/4" I.D. galvanized iron pipe 3.0' long with stamped brass cap.
 10" White Pine, N 70° E, 20.27'
 14" Norway Pine, S 45° E, 77.52'
 4" Poplar, S 70° W, 11.03'
 12" Poplar, N 35° W, 16.17'
 At intersection of North-South and East-West Fencelines.

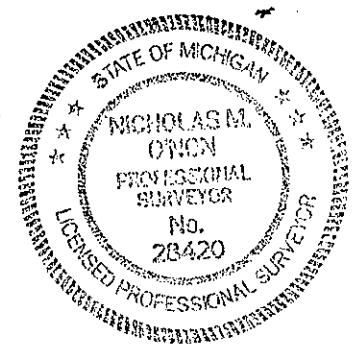

Signed by Nicholas M. O'Non Date December 29, 1994
 Surveyor's Michigan License No. 28420

#392