

MAR 15 2000

SECTION

LAND CORNER RECORDATION CERTIFICATE
Filing Requirement of Act 74, Mich. P.A. 1970


For corners in

Leelanau <small>(County)</small>	Located In:	Corner Code #
1. Public Land Survey	T 31N R 11W	H-5 (Leelanau)
	T R	
	T R	
	T R	
2. Property Controlling in Section	S T R	
	S T R	
3. Miscellaneous Property in Sec.	S T R	
	S T R	

Barbara Kirt 12/29/99
 Leelanau Reg of Deeds 4:10 pm
 Register of Deeds, Stamp & File
 04800002 Number Fee: 9.00
 Page 1 of 1

#650

4. Lot No. _____, Recorded Plat _____
 5. Private Claims _____

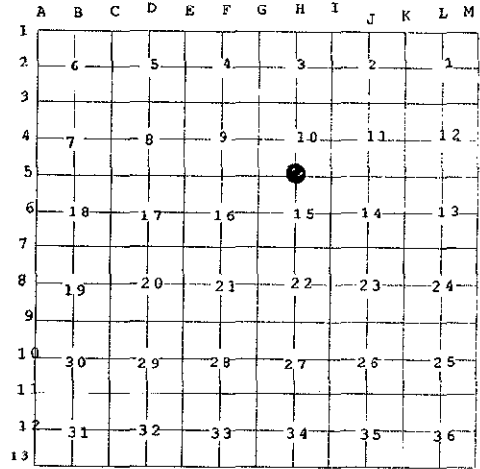

I, David T. Rowe, in a field survey on November 30, 1999 do hereby state that under requirements of P.A. 74, Michigan P.A. of 1970, the corner points mentioned in lines 1 and 2 above were in conformance with regulations and rules therefore as required in the current manual of survey instructions of the United States Department of the Interior, Bureau of Land Management or by a decree of a Court of Law and /or that the corner points mentioned in lines 3, 4 and 5 above were in conformance with the rules of the Michigan Board of Land Surveyors or by a Decree of a Court of Law; established, re-established, monumented, recovered, found as expressed below:

NOTE: Not more than 2 corners, all in the same town and range, may be recorded on this certificate.

A. Description of original monument and accessories and/or subsequent restoration:

- H-5: 1/4 Corner Common to Sections 10 and 15:
 G.L.O. Notes: 1851 Set 1/4 Section Post. 24" Sugar S18°W 25 lks., 4" Beech N41°W 16 lks.
- County Records: 1930's Survey Book 3, Page 133 shows concrete monument. 15" Maple N45°W 129.9', On Fenceline E.-W. No Fence N.-S.
- 1994 N. O'Non, Fd. 4" x 4" Concrete Monument.

B. Description of corner evidence found and/or method applied in restoring or reestablishing corner:

- H-5: 1/4 Corner Common to Sections 10 and 15:
 Fd. Square Concrete Monument in old fallen E.-W. Fenceline.

APPROVED LAND CORNER
 P.A. 345 OF 1990
 LEELANAU COUNTY
 DATE: 11-30-99
 COUNTY REP. [Signature]

C. Description of monument for corner and accessories established to perpetuate locating the position of the corner:

- H-5: 1/4 Corner Common to Sections 10 and 15:
 Found Square Concrete Monument accepted as a careful and faithful re-establishment of the position of the original corner by the Leelanau County Peer Group, November 30, 1999.

- Witnesses:
- N46°W 128.8' Face of 38" Maple
 - N36°W 19.12' Fd. Spike NE. Face 6" Maple
 - N52°W 13.86' Fd. Nail N. Face 4" Ash
 - S55°W 17.92' Set Nail NW. Face 8" Maple
 - N43°E 9.09' Fd. Spike NW. Face 6" Maple
 - S37°E 3.45' Fd. Spike NE. Face Twin 6" Ash



Signed by David T. Rowe
 Surveyor's Michigan License No. 11192

Date Dec 22, 1999