

**SURVEY &
REMONUMENTATION**

MAR 15 2000

SECTION

**LAND CORNER RECORDATION CERTIFICATE
Filing Requirement of Act 74, Mich. P.A. 1970**

For corners in

<u>Leelanau</u> (County)	Located In:	Corner Code #
1. Public Land Survey	T 31N R 11W	I-5 (Leelanau)
	T _____ R _____	_____
	T _____ R _____	_____
	T _____ R _____	_____
2. Property Controlling in Section	S _____ T _____ R _____	_____
	S _____ T _____ R _____	_____
3. Miscellaneous Property in Sec.	S _____ T _____ R _____	_____
	S _____ T _____ R _____	_____

Barbara Kirt 12/29/99
Leelanau Res of Deeds 4:10 PM
BJK Feet 9.00
04600002 P0345 Page 1 of 1


#649

Register of Deeds Stamp & File
Number

4. Lot No. _____, Recorded Plat _____
5. Private Claims _____

I, David T. Rowe, in a field survey on November 30, 1999 do hereby state that under requirements of P.A. 74, Michigan P.A. of 1970, the corner points mentioned in lines 1 and 2 above were in conformance with regulations and rules therefore as required in the current manual of survey instructions of the United States Department of the Interior, Bureau of Land Management or by a decree of a Court of Law and /or that the corner points mentioned in lines 3, 4 and 5 above were in conformance with the rules of the Michigan Board of Land Surveyors or by a Decree of a Court of Law; established, re-established, monumented, recovered, found as expressed below:

NOTE: Not more than 2 corners, all in the same town and range, may be recorded on this certificate.

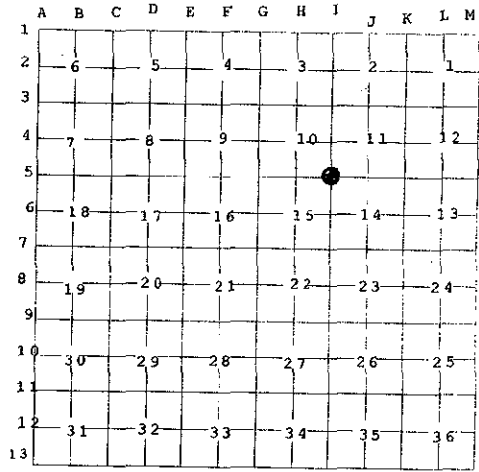

A. Description of original monument and accessories and/or subsequent restoration:

I-5: Corner Common to Sections 10, 11, 14 and 15:

G.L.O. Notes: 1851 Set Post. 4" Beech N54°W 20 lks., 9" Beech S52°E 27 lks.

- County Records: 1930's Survey Book 3, Page 133, 3" iron pipe 4" SE. of old fence corner, fences N. and W., 4" Ash N56°-32'E 14.2', 4" Maple S19°-50'E 9.1', 6" Maple S75°W 5.5'.
- 1994 N. O'Non, Fd. 3" iron pipe. Twin 12" and 15" Maple S80°W 5.47', Clump 12" to 16" Maples S10°E 7.73', 12" Maple N75°E 16.80', 16" Ash N35°E 20.38'.
- 1997 N. O'Non, Same.
- 1998 C. Puller, Fd. 4" iron pipe in intersection of old fence N. and W. S16°E 13" Triple Maple 7.77', S76°W 5" Maple 4.38', N33°E 14" Ash 20.40', N72°E 10" Maple 16.82'.

B. Description of corner evidence found and/or method applied in restoring or reestablishing corner:

I-5: Corner Common to Sections 10, 11, 14 and 15:

Fd. 3" x 36" iron pipe lying on ground from recent excavating near original position. Old standing fences N. and W.

**APPROVED LAND CORNER
P.A. 345 OF 1990
LEELANAU COUNTY**

DATE: 11-30-99

COUNTY REP. [Signature]


C. Description of monument for corner and accessories established to perpetuate locating the position of the corner:

I-5: Corner Common to Sections 10, 11, 14 and 15:

Found 3" iron pipe accepted as a careful and faithful re-establishment of the position of the original corner by the Leelanau County Peer Group, November 30, 1999 and replaced with 3/4" i.d. galvanized 36" long iron pipe with a stamped brass cap.

Witnesses:

- N80°W 5.47' Fd. Spike N. Face Blazed Twin 12" Maple
- S30°W 20.80' Fd. Bent Nail NW. Face 3" Ash
- S70°W 4.38' Fd. Nail SE. Face Blazed 5" Maple
- N64°E 79.42' Set Nail N. Face 14" Ash
- N69°E 98.78' Set Nail SE. Face 14" Maple
- S22°W 62.60' Set Nail SE. Face 12" Maple

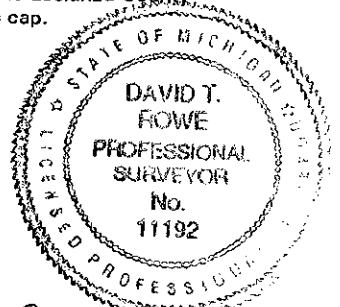

Signed by David T. Rowe
Surveyor's Michigan License No. 11192

Date Dec 22, 1999