

1993

COMMISSION

LAND CORNER RECORDATION CERTIFICATE
Filing Requirement of Act 74, Mich. P.A. 1970

STATE OF MICHIGAN
COUNTY OF LEELANAU
RECEIVED FOR RECORD

1993 DEC 28 PM 4: 23

Barbara Kist
REGISTER OF DEEDS

FILE #313

LIBER 2 PAGE 10

Register of Deeds Stamp & File Number

For corners in

Leelanau
(County)

Located In:

Corner Code #

- | | | |
|------------------------------------|---------------------------|-------------|
| 1. Public Land Survey | T <u>31N</u> R <u>11W</u> | <u>I-13</u> |
| | T _____ R _____ | _____ |
| | T _____ R _____ | _____ |
| | T _____ R _____ | _____ |
| 2. Property Controlling in Section | S _____ T _____ R _____ | _____ |
| | S _____ T _____ R _____ | _____ |
| 3. Miscellaneous Property in Sec. | S _____ T _____ R _____ | _____ |
| | S _____ T _____ R _____ | _____ |

4. Lot No. _____, Recorded Plat _____
5. Private Claims _____

	A	B	C	D	E	F	G	H	I	J	K	L	M
2	6		5		4		3		2		1		
3													
4	7		8		9		10		11		12		
5													
6	18		17		16		15		14		13		
7													
8	19		20		21		22		23		24		
9													
10	30		29		28		27		26		25		
11													
12	31		32		33		34		35		36		
13													

I, Steven P. Bye, in a field survey on December 21, 19 93, do hereby certify that under requirements of P.A. 74, Michigan P.A. of 1970, the corner points mentioned in lines 1 and 2 above were in conformance with regulations and rules therefore as required in the current manual of survey instructions of the United States Department of the Interior, Bureau of Land Management or by a decree of a Court of Law and/or that the corner points mentioned in lines 3, 4 and 5 above were in conformance with the rules of the Michigan Board of Land Surveyors or by a Decree of a Court of Law; established, re-established, monumented, re-monumented, recovered, found as expressed below:

NOTE: Not more than 4 corners, all in the same town and range, may be recorded on this certificate.

A. Description of original monument and accessories and/or subsequent restoration:

I-13: SE corner, Section 34: G.L.O. "Wadsworth 1851 "Set post corner of Section 34 & 35"
Sugar 24 - N 47 W, 19 links
Hemlock 13 - N 48 E, 30 links

County surveyors records: i.p. 7" maple - North 20.8', 12" elm, East 24.1'


B. Description of corner evidence found and/or method applied in restoring or reestablishing corner:

I-13: SE corner, Section 34: 1" iron pipe found fitting County Surveyor's records.
7" maple - North 20.8' (face) now 14" maple (side)
12" elm - East 24.1' (face) now 16" elm stump

C. Description of monument for corner and accessories established to perpetuate locating the position of the corner:

I-13: SE corner, Section 34: 1" iron pipe accepted by the Leelanau County Remonumentation Peer Group, December 9, 1993, and replaced with a 3/4" i.d. galvanized iron pipe 3' long with a brass cap.

- 14" maple - N 05 E, 21.12'
- 14" beech - S 60 E, 38.10'
- 8" yellow birch - S 42 W, 9.80'
- 8" maple - S 03 W, 27.90'

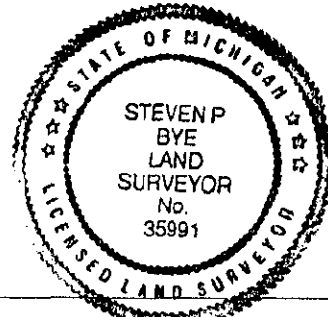

Signed by Steven P. Bye

Date 12-24-93

Surveyor's Michigan License No. 35991