SURVEY &
REMONUMENTATION

APR 28 1995

COMMISSION

STATE OF MICHIGAN
COUNTY OF LEELANAU
RECEIVED FOR RECORD

1994 DEC 12 PM 1:41

Barbara Kirt
REGISTER OF DEEDS

#369

LIBER 2 PAGE 66

Register of Deeds Stamp & File Number

LAND CORNER RECORDATION CERTIFICATE

Filing Requirement of Act 74, Mich. P.A. 1970

For corners in Leelanau (County)

	Located In:	Corner Code #
1. Public Land Survey	T 32N R 11W	E-12
	T ___ R ___	
	T ___ R ___	
	T ___ R ___	
2. Property Controlling	S ___ T ___ R ___	
in Section	S ___ T ___ R ___	
3. Miscellaneous	S ___ T ___ R ___	
Property in Sec.	S ___ T ___ R ___	

4. Lot No. _____, Recorded Plat _____
5. Private Claims _____

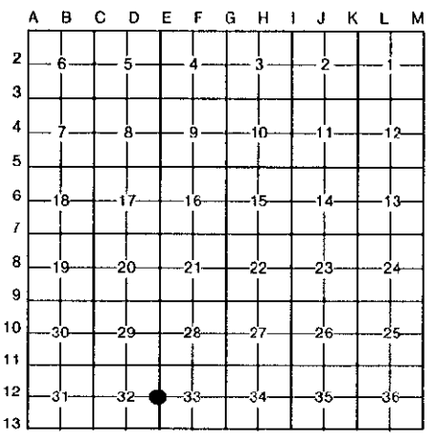

I, Steven P. Bye, in a field survey on November 8, _____, 19 94, do hereby certify that under requirements of P.A. 74, Michigan P.A. of 1970, the corner points mentioned in lines 1 and 2 above were in conformance with regulations and rules therefore as required in the current manual of survey instructions of the United States Department of the Interior, Bureau of Land Management or by a decree of a Court of Law and/or that the corner points mentioned in lines 3, 4 and 5 above were in conformance with the rules of the Michigan Board of Land Surveyors or by a Decree of a Court of Law; established, re-established, monumented, re-monumented, recovered, found as expressed below:

NOTE: Not more than 4 corners, all in the same town and range, may be recorded on this certificate.

A. Description of original monument and accessories and/or subsequent restoration:

E-12: West 1/4 corner of Section 33
W.O. Greene, 1893, states in retracement of old line "40.76 old 1/4 section corner witness trees cut down, but marks plain and correct on stumps, re-established corner".
Sugar 14 N 38 E, 48 links
W. Ash 9 N 51 W, 30 links

B. Description of corner evidence found and/or method applied in restoring or reestablishing corner:

E-12: West 1/4 corner of Section 33
Found 5/8" iron rod with cap #28420, 1' West of centerline South of Peterson Park Rd., set by Nick O'Non 1984, prorated to Brehmers 1935 survey.
O'Non witnesses:
16" Ash N 60 W, 31.40'
12" Double maple S 37 E, 48.70'
13" Ash S 46 W, 45.54'

APPROVED LAND CORNER
P.A. 345 OF 1990
LEELANAU COUNTY
DATE: 10-5-94
COUNTY REP. N.M. O'Non

C. Description of monument for corner and accessories established to perpetuate locating the position of the corner:

E-12: West 1/4 corner of Section 33
5/8" iron rod with cap #28420 accepted by the Leelanau County Remonumentation Peer Review Group, October 5, 1994, and replaced with a 3/4" i.d. galvanized iron pipe 3' long with a brass cap.
16" Ash N 60 W, 31.40'
12" Double maple S 37 E, 48.70'
13" Ash S 46 W, 45.54'
10" Ash N 35 E, 65.95'

STATE OF MICHIGAN
STEVEN P. BYE
LAND SURVEYOR
No. 35991
LICENSED LAND SURVEYOR

Signed by Steven P. Bye Date November 16, 1994

Surveyor's Michigan License No. 35991

FORM APPROVED BY MICHIGAN STATE BOARD OF LAND SURVEYORS, JAN. 28, 1971
REVISED MAY 14, 1975
REVISED JAN., 1983