

SURVEY & REMONUMENTATION

MAR 04 1999

SECTION

LAND CORNER RECORDATION CERTIFICATE
Filing Requirement of Act 74, Mich. P.A. 1970

For corners in

Leelanau
(County)

Located In:

Corner Code #

1. Public Land Survey

T32N R11W K-9
T R
T R
T R
S T R
S T R
S T R
S T R

2. Property Controlling in Section


3. Miscellaneous Property in Sec.

4. Lot No. _____, Recorded Plat _____
5. Private Claims _____

I, David T. Rowe, in a field survey on 12-11, 19 98 do hereby state that under requirements of P.A. 74, Michigan P.A. of 1970, the corner points mentioned in lines 1 and 2 above were in conformance with regulations and rules therefore as required in the current manual of survey instructions of the United States Department of the Interior, Bureau of Land Management or by a decree of a Court of Law and/or that the corner points mentioned in lines 3, 4 and 5 above were in conformance with the rules of the Michigan Board of Land Surveyors or by a Decree of a Court of Law; established, re-established, monumented, recovered, found as expressed below:

NOTE: Not more than 2 corners, all in the same town and range, may be recorded on this certificate.

Barbara Kirt 12/31/98
Leelanau Rec of Deeds 10:02 am
BJK Fee: 9.00
04800002 P0308 Page 1 of 1
#611
Register of Deeds Stamp & File Number

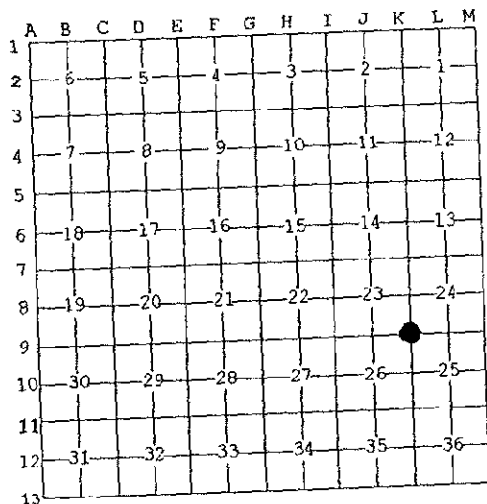

A. Description of original monument and accessories and/or subsequent restoration:

K-9 Corner common to Sections 23, 24, 25 and 26:
G.L.O. Notes: 1855 Established New Corner - 30" Hemlock N28°E 48 lks., 10" Birch S06°E 14 lks
County Records: 1905 F. Greene - Fd. Stone
1939 H. Brehmer - Fd. Iron Pipe Beside Stone - 30" Maple N62°30'R 89.0',
15" Beech S69°00'E 29.8', 8" Beech S86°00'W 46.8'.
Spike Over Split Stone Found - 1985 N. 0' Non
Spike Over Split Stone Found - 1988 N. 0' Non
Iron Found - 1996 D. Heydlauff


B. Description of corner evidence found and/or method applied in restoring or reestablishing corner:

K-9 Corner common to Sections 23, 24, 25 and 26:
Found 1 1/2" x 14" Boat Spike on top of split stone in Pavement Box 0.6' S. C/L-C/L Roads.

APPROVED LAND CORNER
P.A. 345 OF 1990
LEELANAU COUNTY
DATE: 12-10-98
COUNTY REP. [Signature]

C. Description of monument for corner and accessories established to perpetuate locating the position of the corner:

K-9 Corner common to Sections 23, 24, 25 and 26:
1 1/2" x 14" Boat Spike accepted as a careful and faithful perpetuation of the position of the original corner by the Leelanau County Peer Group, 12-10, 1998 and replaced with galvanized 12" long Iron Pipe with a brass cap.
Witnesses: S03°W 33.04' - Found Concrete Monument
S48°W 50.72' - Found Spike in N.W. Face 10" Hemlock
N39°E 74.68' - Found Spike in N.W. Face 10" Red Pine
N21°W 86.46' - Found Spike in E. Face 20" Beech

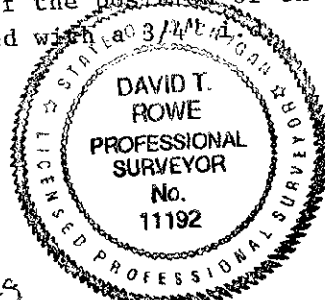

Signed by David T. Rowe
Surveyor's Michigan License No. 11192

Date Dec 29, 1998