

LAND CORNER RECORDATION CERTIFICATE
Filing Requirement of Act 74, Mich. P.A. 1970

For corners in


LEELANAU (County)	Located In:	Corner Code //
1. Public Land Survey	T 34N R 13W	G-4
	T R	
	T R	
	T R	
2. Property Controlling in Section	S T R	
	S T R	
3. Miscellaneous Property in Sec.	S 119 T 34N R 13W	828' W. OF F-5.
	S T R	

Register of Deeds Stamp & File Number

4. Lot No. _____, Recorded Plat _____
 5. Private Claims _____

I, CARL F. ROSER, in a field survey on OCTOBER 16, 19 86, do hereby certify that under requirements of P.A. 74, Michigan P.A. of 1970, the corner points mentioned in lines 1 and 2 above were in conformance with regulations and rules therefore as required in the current manual of survey instructions of the United States Department of the Interior, Bureau of Land Management or by a decree of a Court of Law and/or that the corner points mentioned in lines 3, 4 and 5 above were in conformance with the rules of the Michigan Board of Land Surveyors or by a Decree of a Court of Law, established, re-established, monumented, re-monumented, recovered, found as expressed below:

NOTE: Not more than 4 corners, all in the same town and range, may be recorded on this certificate.

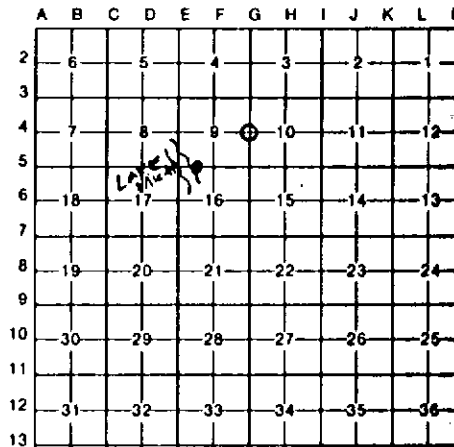

A. Description of original monument and accessories and/or subsequent restoration:

B. Description of corner evidence found and/or method applied in restoring or reestablishing corner:


※ RESTORED REFERENCE POINT TO U.S.M.C. (WEST) ON SOUTH LINE OF FRL, SEC 9 AT "TOP OF RIDGE AT EDGE OF SAND SLIDE--DESCENDING STEEP TO LAKE" (WEST SIDE OF SOUTH FOX IS.).
 NOTE: THE 1847 U.S. (G.L.O.) LINE NOTES SET A POST AT THE TOP OF THIS RIDGE & TOOK TWO CED B.T.'S (THIS IS WHERE WE RESTORED OUR Ref. U.S.M.C.) & THEN DESCENDED 5.45 CHAINS TO "FOOT OF BALD SAND & CLAY BANKS ON SHORE OF L. MICH"; NO BEARINGS, NO POST SET. THE TOP OF RIDGE IS VERY DEFINITE, RUNS N12°W± & IS ONLY 8'± WIDE. TO QUOTE THE U.S.(G.L.O.) LINE NOTES RUNNING WEST FROM S 1/4 COR OF SEC 9; "TO FOOT OF STEEP RIDGE ASCENDING WEST" 8.10 CHAINS, AND 12.55 CHAINS "TO TOP RIDGE--ETC". THERE IS ONLY ONE SPOT WHERE THE S LINE OF SEC 9 CAN HIT 8.10 CH. "ASCENDING WEST" WITHIN A LAT OF ±10' & FIT TOP RIDGE AT 12.55 CHAINS.

G-4 RE-ESTAB'D. E 1/4 COR OF SEC 9 EQUIDISTANT & ON LINE BETW NE & SE CORNERS OF SEC 9. A FENCE COR POST HOLE (FN'S N-E-W) IS S51°59'W, 39.8'. MAIN N-S GRAVEL & SAND TRAIL ROAD IS EAST 250'±.

C. Description of monument for corner and accessories established to perpetuate locating the position of the corner:

※
 DROVE 1" X 60" PIPE W/RLS CAP & SET CED POST W/LOC TAG.
 11" ASH N16°E 21.3'
 5" MAPLE N22°W 11.9'
 11" ASH S70°E 29.0'
 7" ASH N60°E 20.5'

G-4
 DROVE 1" X 40" PIPE W/RLS CAP & SET CED POST W/LOC TAG.
 7" MAPLE N58°E 2.6'
 6" MAPLE S62°E 16.7'
 12" MAPLE S52°W 12.5'
 7" IRONWD N50°W 22.3'

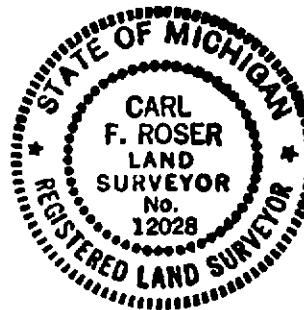

Signed by Carl F. Roser 12-29-86 Date _____

Surveyor's Michigan License No. 12028