

LAND CORNER RECORDATION CERTIFICATE
Filing Requirement of Act 74, Mich. P.A. 1970

For corners in
LENAWEE COUNTY

(County)

	Located In:	Corner Code #
1. Public Land Survey	T <u>55</u> R <u>1E</u>	<u>M-4</u>
	T _____ R _____	_____
	T _____ R _____	_____
	T _____ R _____	_____
2. Property Controlling in Section	S _____ T _____ R _____	_____
	S _____ T _____ R _____	_____
3. Miscellaneous Property in Sec.	S <u>12</u> T <u>55</u> R <u>1E</u>	<u>Point on Range Line</u>
	S _____ T _____ R _____	_____

Register of Deeds Stamp & File Number

4. Lot No. _____, Recorded Plat _____
 5. Private Claims _____

I, Gary C. Bilow, in a field survey on March 21, 19 91, do hereby certify that under requirements of P.A. 74, Michigan P.A. of 1970, the corner points mentioned in lines 1 and 2 above were in conformance with regulations and rules therefore as required in the current manual of survey instructions of the United States Department of the Interior, Bureau of Land Management or by a decree of a Court of Law and/or that the corner points mentioned in lines 3, 4 and 5 above were in conformance with the rules of the Michigan Board of Land Surveyors or by a Decree of a Court of Law, established, re-established, monumented, re-monumented, recovered, found as expressed below.

NOTE: Not more than 4 corners, all in the same town and range, may be recorded on this certificate.

	A	B	C	D	E	F	G	H	I	J	K	L	M
2	6		5		4		3		2		1		
3													
4	7		8		9		10		11		12		
5													
6	18		17		16		15		14		13		
7													
8	19		20		21		22		23		24		
9													
10	30		29		28		27		26		25		
11													
12	31		32		33		34		35		36		
13													

A. Description of original monument and accessories and/or subsequent restoration:

M-4: Corner established by U.S. Gov't Deputy Surveyor B. Hough in 1815 - accessories: B. Oak 12, N76W, 49 links; B. Oak 10, N68-1/2E, 36 links. Michigan Department of Conservation Surveyor W. Lee Paddison re-established corner in Feb. 1959 as "set 1" iron pipe with brass cap - accessory: S2° 3'E, 139.3', 22" B. Oak." Corner recorded under Act 74, P.A. 1970 by Glenn Richard (RLS #13040) in Liber 1 Page 77 as "found corner as described by Paddison on MDCS drawing (plan #E46A-1) - accessories: nothing to witness to."

Point on Range Line: Michigan Department of Conservation Surveyor W. Lee Paddison established this point on the Range Line on the North side of Grassy Lake in 1959 and documented on MDCS drawing (plan #E46A-1) as "set 3/4" iron pipe - accessories: N19E, 20.18', 16" W. Oak; S81.5E, 18.30', 7" B. Oak; N65E, 10.33', 12" B. Oak." Corner recorded under Act 132 in 1971 in Liber 1 Page 93 by Glenn Richard (RLS #13040) as "found iron pipe set by Mich. Depart. of Conservation Survey in 1959 - accessories: N20W, 8.35', nail in 10" Oak; N19E, 20.53', nail in 16" Oak; S81E, 16.35', nail in 7" Oak."

B. Description of corner evidence found and/or method applied in restoring or reestablishing corner:

M-4: Found 3/4" pipe - no witnesses recovered. Distances to adjacent corners as depicted on Paddison's drawing are reasonable and consistent. Accepted this corner as the best evidence of the original GLO corner.


Point on Range Line: Found 3/4" pipe on North side of Grassy Lake - no witness recovered. Distances to irons depicted on Paddison's drawing are reasonable and consistent. Distances on Glenn Richard's (RLS 12030) Certificate of Survey as recorded in Liber 1 Page 93 are reasonable and consistent. Accepted this iron as marking the Range Line between Section 12 in T55, R1E and Section 7 in T55, R2E.

C. Description of monument for corner and accessories established to perpetuate locating the position of the corner:

M-4: Found 3/4" pipe
 North, 2.28', nail & Michigan Department of Natural Resources Tag in 10" Oak
 S59E, 10.96', nail & MDNR tag in 2" Cherry
 S5W, 65.55', nail & MDNR tag in 24" Cherry
 S10E, 34.58', double headed nail in 8" Oak

Point on Range Line: Found 3/4" pipe
 N73W, 28.86', nail & Michigan Department of Natural Resources Tag in 7" Maple
 N18W, 15.61', nail & MDNR tag in 10" Oak
 N4W, 18.19', nail & MDNR tag in 8" Oak
 N21E, 20.20', nail & MDNR tag in 14" Oak

Signed by Gary C. Bilow Date 5/20/91
 Surveyor's Michigan License No. 26453

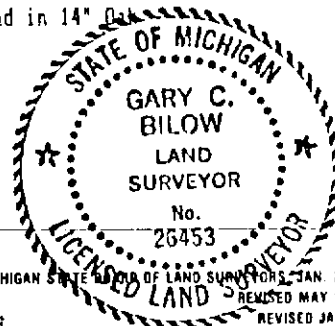

FORM APPROVED BY MICHIGAN STATE BOARD OF LAND SURVEYORS, JAN. 28, 1971
 REVISED MAY 14, 1975
 REVISED JAN., 1983