

APR 01 1996
COMMISSION

LAND CORNER RECORDATION CERTIFICATE
Filing Requirement of Act 74, Mich. P.A. 1970

LIBER 001 PAGE 87

For corners in Lenawee Located In: _____ Corner Code # _____
(County)

1. Public Land Survey T-5-S R-1-E J-5
T _____ R _____
T _____ R _____
T _____ R _____

2. Property Controlling S _____ T _____ R _____
in Section S _____ T _____ R _____

3. Miscellaneous S _____ T _____ R _____
Property in Sec. S _____ T _____ R _____

4. Lot No. _____, Recorded Plat _____

5. Private Claims _____

FILED
NOV 22 1995
11:52 AM
LENAWEE COUNTY
JEANETTE D. KNOX
REGISTER OF DEEDS
Register of Deeds Stamp & File Number

	A	B	C	D	E	F	G	H	I	J	K	L	M
1													
2	6	5	4	3	2	1							
3													
4	7	8	9	10	11	12							
5													
6	18	17	16	15	14	13							
7													
8	19	20	21	22	23	24							
9													
10	30	29	28	27	26	25							
11													
12	31	32	33	34	35	36							
13													


I, Glenn E. Richard, in a field survey on August 16, 1995, do hereby certify that under requirements of P.A. 74, Michigan P.A. of 1970, the corner points mentioned in lines 1 and 2 above were in conformance with regulations and rules therefore as required in the current manual of survey instructions of the United States Department of the Interior, Bureau of Land Management or by a decree of a Court of Law and/or that the corner points mentioned in lines 3, 4 and 5 above were in conformance with the rules of the Michigan Board of Land Surveyors or by a Decree of a Court of Law; established, re-established, monumented, re-monumented, recovered, found as expressed below:

NOTE: Not more than 4 corners, all in the same town and range, may be recorded on this certificate.

A. Description of original monument and accessories and/or subsequent restoration:
G.L.O. February 1824 Robert Clark set 1/4 Sec post W. Oak 10 N 33° W 33 B. Oak 14 S 35° E 22
February 27, 1874 B. Kent surveyed NE 1/4 of Section 14 but didn't describe type of monument at the corner
August 1940, Harold Clegg found stone and set iron pipes 33' East and West and spike 1' North
October 1974, I dug and found the boat spike and the iron pipe west but I thought the spike was over the stone, and recorded it in Liber 2 Page 695.
September 1975, K. Suydam found the boat spike, replaced it with a re-rod and recorded it as being 1.0 foot North of the stone and recorded it in Liber 3 Page 303

B. Description of corner evidence found and/or method applied in restoring or reestablishing corner:
October 5, 1994 Dug up the pavement and found the stone and the re-rod. The cut in the top of the stone called for in H. Cleggs survey measured 0.88 South of the re-rod. Also found iron pipe 33' West. The stone split in two while drilling to set something in the top of the stone. Set 3/4" X 3' iron pipe in between the two halves of the stone. The road was under re-construction in 1994 and was repaved in May of 1995.
August 16, 1995, found 3/4" iron pipe in Monument box as described above in October 1994..

C. Description of monument for corner and accessories established to perpetuate locating the position of the corner:
3/4" X 3' gas pipe capped G.E.R. P.S. 13040 in monument box as accepted as the best available evidence of the position of the original corner.
Re-rod 2' North of fence East 77.65
Re-rod 2' North of fence East 47.50 and 0.32 North of above re-rod
Iron pipe west 32.97 (buried 12" deep)
DBI hd nail and disc in 12" Oak West 162.61
East edge of Pass with Care sign post S 5 W 222.45

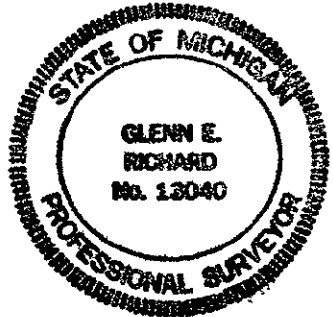

Ratified by Peer Group in accordance with P.A. 345 Co. Rep. Glenn E. Richard Date 9-18-95
Signed by Glenn E. Richard Date 10-9-95
Glenn E. Richard

Surveyor's Michigan License No. 13040