

SURVEY & REMONUMENTATION

JAN 15 1998

Filed under Remonumentation Act 345 of 1990 LIBER 1 PAGE 233
LAND CORNER RECORDATION CERTIFICATE

SECTION

Filing Requirement of Act 74, Mich. P.A. 1970

STATE OF MICHIGAN
 LENAWEE COUNTY
 FILED

For corners in

<u>Lenawee</u> (County)	Located in:	Corner Code #
1. Public Land Survey	T - 5-S R - 4-E	J-7
	T _____ R _____	_____
	T _____ R _____	_____
	T _____ R _____	_____
2. Property Controlling in Section	S _____ T _____ R _____	_____
	S _____ T _____ R _____	_____
3. Miscellaneous Property in Sec	S _____ T _____ R _____	_____
	S _____ T _____ R _____	_____

22 DEC 97 9:25 A.M.

VICTORIA J. DANIELS
 REGISTER OF DEEDS

Register of Deeds Stamp & File Number

4. Lot No. _____, Recorded Plat _____
 5. Private Claims _____

I, Glenn E. Richard, in a field survey on September 26, 1997, do hereby certify that under requirements of P.A. 74, Michigan P.A. of 1970, the corner points mentioned in lines 1 and 2 above were in conformance with regulations and rules therefore as required in the current manual of survey instructions of the United States Department of the Interior, Bureau of Land Management or by a decree of a Court of Law and/or that the corner points mentioned in lines 3, 4 and 5 above were in conformance with the rules of the Michigan Board of Land Surveyors or by a Decree of a Court of Law; established, re-established, monumented, re-monumented, recovered, found as expressed below:

	A	B	C	D	E	F	G	H	I	J	K	L	M
1													
2	6	5	4	3	2	1							
3													
4	7	8	9	10	11	12							
5													
6	16	17	16	15	14	13							
7													
8	19	20	21	22	23	24							
9													
10	30	29	28	27	26	25							
11													
12	34	32	33	34	35	36							
13													

NOTE: Not more than 4 corners, all in the same town and range, may be recorded on this certificate.

A. Description of original monument and accessories and/or subsequent restoration:

- GLO 1819 Joseph Fletcher set 1/4 section post W. Oak 8 S 70 E 15 W. Oak 11 N 41 W 26
- 1849 S.C. Boughton subdivided Section 14. Type of monumentation not given
- 1851 S.C. Boughton subdivided Section 23. Type of monumentation not given
- 1964 K.L. Suydam found 1/2" X 1" X ? iron bar
- 1965 I found 3/8" X 1" X ? iron bar
- 1972 George North (employed by W.E.F. and Assoc.) found 1/2" X 1" X ? iron bar
- 1975 I found 3/8" X 1" X ? iron bar and recorded it in L 3, P 197
- 1976 K.L. Suydam survey. Type of monumentation not given
- 1979 K.L. Suydam 3/4" iron pipe
- 1979 I found 3/4" iron pipe
- 1993 I found 3/4" iron pipe


B. Description of corner evidence found and/or method applied in restoring or reestablishing corner:

Sept. 26, 1997 Len. Co. Road Comm. had just paved road after grading ditches & placing stone base. Dug through newly laid pavement and found 3/4" X 14" iron pipe but no trace of the iron bar. Set 3/4" X 3' iron pipe capped G.E.R. 13040 in a monument box. It appears the iron bar may have been 0.8+/- west of the approved location. The iron pipes set using the iron bar have been hit, tipped and bent.

C. Description of monument for corner and accessories established to perpetuate locating the position of the corner:

3/4" X 3' iron pipe capped G.E.R. 13040 in monument box and is accepted as the best available evidence of the position of the original corner.

- NW corner of brick house # 5550 N 45° E 204.43
- SE corner of brick house #5550 N 60° E 238.71
- NE corner of concrete block foundation House # 5533 S 50° E 129.75
- NW corner of concrete block foundation House # 5533 S 30° E 98.90

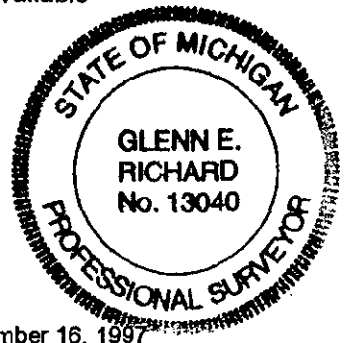

Ratified by Peer Group in accordance with P.A. 345 Co. Rep. Glenn E. Richard Date December 16, 1997

Signed by Glenn E. Richard Date 12-17-97
 Glenn E. Richard

Surveyor's Michigan License No. 13040