JAN 2 5 2000

SECTION

Filed under Remonumentation Act 345 of 1990

LAND CORNER RECORDATION CERTIFICATE

Filing Requirement of Act 74, Mich. P.A. 1970

LIBER 1 PAGE 324
STATE OF MICHIGAN
LENAWEE COUNTY
FILED

14 JUL 1999 6:33:08 PM

VICTORIA J. DANIELS
REGISTER OF DEEDS

Register of Deeds Stamp & File Number

For corners in Lenawee (County)

		Located In:	Corner Code #
1. Public Land Survey		T-5-S R-5-E	G-13
		T R	
		T R	
		T R	
2. Property Controlling	S	T R	
in Section	S	T R	
3. Miscellaneous	S	T R	
Property in Sec	S	T R	

4. Lot No. _____, Recorded Plat _____
5. Private Claims _____

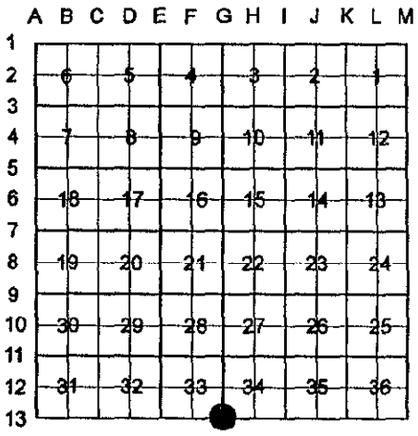

I, Glenn E. Richard, in a field survey on July 6, 1999, do hereby certify that under requirements of P.A. 74, Michigan P.A. of 1970, the corner points mentioned in lines 1 and 2 above were in conformance with regulations and rules therefore as required in the current manual of survey instructions of the United States Department of the Interior, Bureau of Land Management or by a decree of a Court of Law and/or that the corner points mentioned in lines 3, 4 and 5 above were in conformance with the rules of the Michigan Board of Land Surveyors or by a Decree of a Court of Law; established, re-established, monumented, re-monumented, recovered, found as expressed below:

NOTE: Not more than 4 corners, all in the same town and range, may be recorded on this certificate.

A. Description of original monument and accessories and/or subsequent restoration:

G.L.O. 1815 Alex Holmes set post cor. Sec.'s 33 & 34 Sugar 16 N 25 E 12 Elm 6 S 30 W 17
Couldn't find any information on this corner in all of the old survey records.
1940 Harold Clegg surveyed for relocation of road curves. He set 14" boat spike at (GLO jog 5.63 ch=371.58') east of stone he found at G-1 T6S R5E
1968 W.E. Sommer RLS 12030 found boat spike 371.41 east of stone at G-1 T6S R5E
1981 I set a iron pipe 0.54 north of a found boat spike by extending the line east from the S 1/4 corner of Section 33 T5S over the stone at the NE corner of Sec. 4 T6S and recorded it in L5, P10
1983 W.E. Frazier & Associates found iron pipe
1997 Found iron pipe under newly layed asphalt pavement. Replaced the FIP with 3/4" X 3' iron pipe and set monument box.

. Description of corner evidence found and/or method applied in restoring or reestablishing corner:

July 6, 1999 Found 3/4" iron pipe in monument box. Drove the iron pipe down with 5/8" X 3' re-rod inside of it and capped with Lenawee County Re-mon cap stamped P.S. 13040

- Description of monument for corner and accessories established to perpetuate locating the position of the corner:

5/8" X 3' re-rod with Lenawee County Re-mon cap stamped P.S. 13040 in monument box and is accepted as the best available evidence of the position of the original corner.

NW corner of brick hse N 35° E 149.88
SW corner of garage foundation N 75° E 128.30
dbl hd nail & Lenawee County re-mon tag in E.P. S 50° W 49.60
dbl hd nail & disc in E.P. N 80° W 119.56

STATE OF MICHIGAN
GLENN E. RICHARD
No. 13040
PROFESSIONAL SURVEYOR

tified by Peer Group in accordance with P.A. 345 Co. Rep. Glenn E. Richard Date June 22, 1999

ned by Glenn E. Richard Date0 July 8, 1999
Glenn E. Richard

veyor's Michigan License No. 13040

FORM APPROVED BY MICHIGAN STATE BOARD OF LAND SURVEYORS, JAN. 28, 1971
REVISED MAY 14, 1975
REVISED JAN., 1983
ADAPTED FOR WORD PROCESSING MARCH, 1993