SURVEY & REMONUMENTATION

APR 28 1995

COMMISSION

Filed under Remonumentation Act 345 of 1990 LIBER 001 PAGE 61

LAND CORNER RECORDATION CERTIFICATE

Filing Requirement of Act 74, Mich. P.A. 1970

FILED

DEC 29 1994 3:51PM.

LENAWEE COUNTY
JEANETTE D. KNOX
REGISTER OF DEEDS

Register of Deeds Stamp & File Number

For corners in Lenawee (County)

	Located In:	Corner Code #
1. Public Land Survey	T-6-S R-1-E	E-11
	T___ R___	
	T___ R___	
	T___ R___	
2. Property Controlling	S___ T___ R___	
in Section	S___ T___ R___	
3. Miscellaneous	S___ T___ R___	
Property in Sec.	S___ T___ R___	

4. Lot No. _____, Recorded Plat _____
5. Private Claims _____

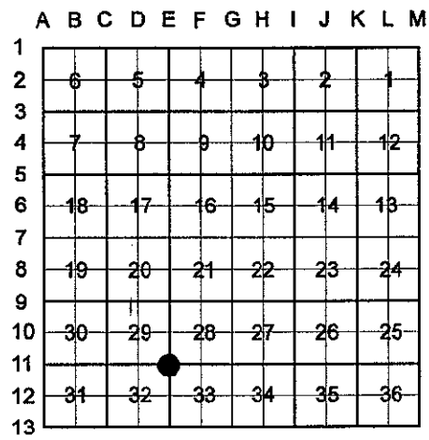

I, Glenn E. Richard, in a field survey on December 13, 1994, do hereby certify that under requirements of P.A. 74, Michigan P.A. of 1970, the corner points mentioned in lines 1 and 2 above were in conformance with regulations and rules therefore as required in the current manual of survey instructions of the United States Department of the Interior, Bureau of Land Management or by a decree of a Court of Law and/or that the corner points mentioned in lines 3, 4 and 5 above were in conformance with the rules of the Michigan Board of Land Surveyors or by a Decree of a Court of Law; established, re-established, monumented, re-monumented, recovered, found as expressed below:

NOTE: Not more than 4 corners, all in the same town and range, may be recorded on this certificate.

A. Description of original monument and accessories and/or subsequent restoration:

G.L.O. October 1815, Thomas Evans, Set post cor. Sec. 28, 29, 32 & 33 Beech 6 S 16 E 9, Beech 6 N 44E 13
February 1880. G.E. Kedzie, County Surveyor ran West 38.93 chains to center of highway, (this point being accepted as the section corner was lost) No description of monument.
June 1881, James Blair set a stake for the corner by extending the line North from the found section corner on the township line and the found 1/4 corner common to Sections 32 & 33.
February 1891, James Blair surveys showns the corner as "stake".
Early 1900's J.L. Richard records show stone found 44 3/4 links S. & 1 3/4' West of tile corner set on road survey.
March 25, 1975, I dug with a back hoe and found stone, crockery, piece of iron, piece of plow point on top of cedar stake. I replaced the cedar stake with a 3/4" X 4' iron pipe and recorded it in L. 3, P. 145.
1975, K.L. Suydam found my iron pipe and recorded it in L. 3, P. 246.

B. Description of corner evidence found and/or method applied in restoring or reestablishing corner:

December 15, 1994, Found iron pipe in monument box which checked the remaining witnesses. Replaced the iron pipe with a 3/4" X 3' iron pipe capped P.S. 13040 and raised the monument box to the surface of the existing pavement with an adjusting ring.

C. Description of monument for corner and accessories established to perpetuate locating the position of the corner:

3/4" X 3' iron pipe capped P.S. 13040 in monument box and is accepted as the best available evidence of the position of the original corner.
Iron pipe buried 15" deep in field West 40.00
Iron pipe buried 15" deep in field East 40.01
Hex. iron West 22.02
"X" cut on west end C.M.P. N 15° W 61.82
"X" cut on east end C.M.P. N 15° E 60.38
Fd. nail & disc in Elec. pole S 15° E 139.62

STATE OF MICHIGAN
GLENN E. RICHARD
No. 13040
PROFESSIONAL SURVEYOR

Ratified by Peer Group in accordance with P.A. 345 Co. Rep. Glenn E Richard Date December 22, 1994

Signed by Glenn E Richard Date Dec 23, 1994
Glenn E. Richard

Surveyor's Michigan License No. 13040

FORM APPROVED BY MICHIGAN STATE BOARD OF LAND SURVEYORS, JAN. 28, 1971

REVISED MAY 14, 1975
REVISED JAN., 1983
ADAPTED FOR WORD PROCESSING MARCH, 1993