

MAY 16 1997

COMMISSION

Filed Under Remonumentation Act 345 of 1990

LAND CORNER RECORDATION CERTIFICATE

Filing Requirement of Act 74, Mich. P.A. 1970

LIBER 001 PAGE 133

For corners in

Lenawee

(County)

Located In:

Corner Code #

- 1. Public Land Survey T - 6 - S R - 1 - E G-9  
T \_\_\_\_\_ R \_\_\_\_\_  
T \_\_\_\_\_ R \_\_\_\_\_  
T \_\_\_\_\_ R \_\_\_\_\_
- 2. Property Controlling S \_\_\_\_\_ T \_\_\_\_\_ R \_\_\_\_\_  
in Section S \_\_\_\_\_ T \_\_\_\_\_ R \_\_\_\_\_
- 3. Miscellaneous S \_\_\_\_\_ T \_\_\_\_\_ R \_\_\_\_\_  
Property in Sec. S \_\_\_\_\_ T \_\_\_\_\_ R \_\_\_\_\_

STATE OF MICHIGAN  
LENAWEE COUNTY  
FILED

13 NOV 96 9:06 A.M.

JEANETTE D. KNOX  
REGISTER OF DEEDS

Register of Deeds Stamp & File Number

- 4. Lot No. \_\_\_\_\_, Recorded Plat \_\_\_\_\_
- 5. Private Claims \_\_\_\_\_

	A	B	C	D	E	F	G	H	I	J	K	L	M
1.													
2.	6	5	4	3	2	1							
3.													
4.	7	8	9	10	11	12							
5.													
6.	18	17	16	15	14	13							
7.													
8.	19	20	21	22	23	24							
9.													
10.	30	29	28	27	26	25							
11.													
12.	31	32	33	34	35	36							
13.													

I, Glenn E. Richard, in a field survey on July 12 1996, do hereby certify that under requirements of P.A. 74, Michigan P.A. of 1970, the corner points mentioned in lines 1 and 2 above were in conformance with regulations and rules therefore as required in the current manual of survey instructions of the United States Department of the Interior, Bureau of Land Management or by a decree of a Court of Law and/or that the corner points mentioned in lines 3, 4 and 5 above were in conformance with the rules of the Michigan Board of Land Surveyors or by a Decree of a Court of Law; established, re-established, monumented, re-monumented, recovered, found as expressed below:

**NOTE: Not more than 4 corners, all in the same town and range, may be recorded on this certificate.**

**A. Description of original monument and accessories and/or subsequent restoration:**


G.L.O. Oct 1815 Thomas Evans set post corner Sec. 21, 22, 27 & 28 Beech 12 N 26 W 16 Beech 12 S 38 W 15  
 1881 James Blair found bricks  
 J.L. Richard early 1900's record called for bricks  
 1919 W.E. Frazier re-established the corner "Drove gas pipe" while surveying Townley Highway  
 1958 W.E. Frazier & Assoc. found the iron pipe and raised it with a boat spike  
 1961 M.D.O.T. found the boat spike  
 1974 I found the boat spike & recorded it in Liber 3, Page 81

**B. Description of corner evidence found and/or method applied in restoring or reestablishing corner:**

May 1995 The pavement was being torn up. I dug and found boat spike in top of iron pipe & piece of wood stake next to the iron pipe. Dug larger hole but didn't find any trace of bricks.  
 July 12, 1996 Found 3/4" X 3' gas pipe 16" under 1st course of asphalt. Raised the iron pipe by placing 1/2" X 12" iron pipe under the 3' gas pipe and set monument box.

**C. Description of monument for corner and accessories established to perpetuate locating the position of the corner:**

3/4" X 3' gas pipe capped G.E.R. 13040 in monument box and is accepted as the best available evidence of the position of the original corner.  
 Found dbl. hd. nail & disc in 24" Maple 87.72  
 Found dbl. hd. nail & disc in 14" Maple 63.62  
 Found iron pipe N 60 W 99.98  
 SE. corner of old stone school house N 70 W 170.63  
 Found dbl. hd. nail & M.D.O.T. tag in E.P. S 70 W 67.80

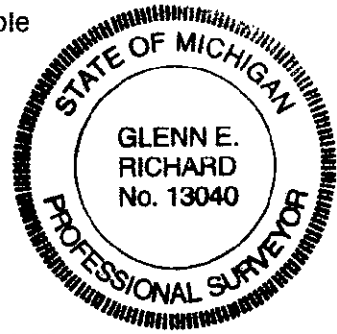

Ratified by Peer Group in accordance with P.A. 345

Co. Rep. Glenn E. Richard Date 8-6-96

Signed by Glenn E. Richard Date 10-11-96  
 Glenn E. Richard

Surveyor's Michigan License No. 13040