

SURVEY & REMONUMENTATION

NOV 07 1994

COMMISSION

Filed under Remonumentation Act 345 of 1990
LAND CORNER RECORDATION CERTIFICATE
 Filing Requirement of Act 74, Mich. P.A. 1970

LIBER **001** PAGE **35**

For corners in
Lenawee Located In: _____ Corner Code # _____
 (County)

1. Public Land Survey T-6-S R-3-E K-3
 T _____ R _____
 T _____ R _____
 T _____ R _____

2. Property Controlling S _____ T _____ R _____
 in Section S _____ T _____ R _____

3. Miscellaneous S _____ T _____ R _____
 Property in Sec. S _____ T _____ R _____

FILED 10:56 AM
 OCT 28 1994
 LENAWEE COUNTY
 JEANETTE D. KNOX
 REGISTER OF DEEDS
 Register of Deeds Stamp & File Number

4. Lot No. _____ Recorded Plat _____
 5. Private Claims _____

	A	B	C	D	E	F	G	H	I	J	K	L	M
1													
2	6	5	4	3	2	1							
3													
4	7	8	9	10	11	12							
5													
6	18	17	16	15	14	13							
7													
8	19	20	21	22	23	24							
9													
10	30	29	28	27	26	25							
11													
12	31	32	33	34	35	36							
13													

I, Glenn E. Richard, in a field survey on October 10 1994, do hereby certify that under requirements of P.A. 74, Michigan P.A. of 1970, the corner points mentioned in lines 1 and 2 above were in conformance with regulations and rules therefore as required in the current manual of survey instructions of the United States Department of the Interior, Bureau of Land Management or by a decree of a Court of Law and/or that the corner points mentioned in lines 3, 4 and 5 above were in conformance with the rules of the Michigan Board of Land Surveyors or by a Decree of a Court of Law; established, re-established, monumented, re-monumented, recovered, found as expressed below:

NOTE: Not more than 4 corners, all in the same town and range, may be recorded on this certificate.

A. Description of original monument and accessories and/or subsequent restoration:


G.L.O. January 1824, John Mack set post cor Sec. 1, 2, 11 & 12, Elm 34, N 38 E 24, Elm 8 S 35 W 41.
 May 1838, Survey of Sec 11 shown in Satterthwaite book but monuments are not described.
 July 1948, During a survey for road re-construction a stone was found 2' deep.
 April 1960, I found spike (over stone) and replaced it with iron pipe.
 November 1971, W.E. Sommer found iron pipe and recorded it in L. 1, P. 75.

B. Description of corner evidence found and/or method applied in restoring or reestablishing corner:

October 10, 1994, Found iron pipe 12" deep in monument box.

C. Description of monument for corner and accessories established to perpetuate locating the position of the corner:

3/4" X 27" iron pipe on top of stone capped G.E.R, P.S. 13040 in monument box and is accepted as the best available evidence of the position of the original corner.
 Cut "X" on C.M.P. N 20° W 36.53
 Cut "X" on C.M.P. N 40° E 33.66
 NW cor. conc. block foundation of Grange S 35° E 79.63
 NE face of 4" well casing S 60° W 147.76
 NE corner brick (above stone foundation) old school bldg. S 70° W 178.38

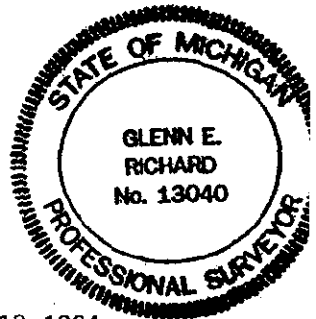

Ratified by Peer Group in accordance with P.A. 345 Co. Rep. Glenn E. Richard Date October 13, 1994
 Signed by Glenn E. Richard Date Oct 20, 1994
 Glenn E. Richard
 Surveyor's Michigan License No. 13040