

MAY 16 1997

COMMISSION

Filed under Remonumentation Act 345 of 1970 ORDER 1 PAGE 146

LAND CORNER RECORDATION CERTIFICATE

Filing Requirement of Act 74, Mich. P.A. 1970

STATE OF MICHIGAN
LENAWEE COUNTY
FILED

3 DEC 96 3:21 P.M.

JEANETTE D. KNOX
REGISTER OF DEEDS

For corners in Lenawee Located In: _____ Corner Code # _____
(County)

1. Public Land Survey T-6-S R-3-E M-12
T _____ R _____
T _____ R _____
T _____ R _____

2. Property Controlling S _____ T _____ R _____
in Section S _____ T _____ R _____

3. Miscellaneous S _____ T _____ R _____
Property in Sec S _____ T _____ R _____

Register of Deeds Stamp & File Number

4. Lot No. _____, Recorded Plat _____
5. Private Claims _____

	A	B	C	D	E	F	G	H	I	J	K	L	M
1													
2	6	5	4	3	2	1							
3													
4	7	8	9	10	11	12							
5													
6	18	17	16	15	14	13							
7													
8	19	20	21	22	23	24							
9													
10	30	29	28	27	26	25							
11													
12	31	32	33	34	35	36							
13													

I, Glenn E. Richard, in a field survey on September 26 19 96, do hereby certify that under requirements of P.A. 74, Michigan P.A. of 1970, the corner points mentioned in lines 1 and 2 above were in conformance with regulations and rules therefore as required in the current manual of survey instructions of the United States Department of the Interior, Bureau of Land Management or by a decree of a Court of Law and/or that the corner points mentioned in lines 3, 4 and 5 above were in conformance with the rules of the Michigan Board of Land Surveyors or by a Decree of a Court of Law; established, re-established, monumented, re-monumented, recovered, found as expressed below:

NOTE: Not more than 4 corners, all in the same town and range, may be recorded on this certificate.

A. Description of original monument and accessories and/or subsequent restoration:


G.L.O. February 1816, Joseph Fletcher set 1/4 section post W. Oak 10 S 29 E 25, W. Oak 9 S 28 W 27
James Blair records show B. Kent used the corner in 1876 (type of monument is not noted).
April 1882, James Blair found stake and stones.
1940, Consumers Power Company "searched for corner, didn't find, used fence corner and 288.75' North from A-1, T7S-R4E"
1941, Harold Clegg (W.E.F. Employee) "Found stone, brick & dark spot in clay, added 2' strap iron" 10" Apple S 60 W 37.0
January 1973, Werner Sommer "Found 2 rocks & strap iron", Set 3/4" strap iron and recorded it in L. 2, P. 269.

B. Description of corner evidence found and/or method applied in restoring or reestablishing corner:

September 26, 1996, I found the iron pipe as recorded in L. 2, P. 269. I dug and found the iron pipe wedged over the strap iron, 2 stones & 5 pieces of bricks and 16" Apple (poor condition) S 60° W 37". Set 30" Harrison Monument stamped P.S. 13040 in place of the iron pipe with the stone and bricks around it and marked it with a Carsonite post.

C. Description of monument for corner and accessories established to perpetuate locating the position of the corner:

30" Harrison Monument stamped P.S. 13040 and is accepted as the best available evidence of the position of the original corner.
Dbl. hd. nail & disc in 10" Hickory S 85° W 13.93
Dbl. hd. nail & disc in 14" Elm N 10° E 16.09
Dbl. hd. nail & disc in 8" Hickory S 5° W 16.13
Found Dbl. hd. nail & disc in Elec. pole S 45° W 19.32

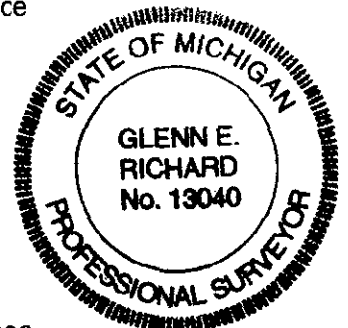

Ratified by Peer Group in accordance with P.A. 345 Co. Rep. Glenn E. Richard Date 10-08-1996
Signed by Glenn E. Richard Date Nov. 27, 1996
Glenn E. Richard
Surveyor's Michigan License No. 13040