

SURVEY & REMONUMENTATION

APR 28 1995

COMMISSION

Filed under Remonumentation Act 345 of 1990
LAND CORNER RECORDATION CERTIFICATE
 Filing Requirement of Act 74, Mich. P.A. 1970

LIBER **001** PAGE **47**

For corners in
Lenawee Located In: Corner Code #
 (County)

1. Public Land Survey T-6-S R-4-E H-1
 T R
 T R
 T R

2. Property Controlling S T R
 in Section S T R

3. Miscellaneous S T R
 Property in Sec. S T R

FILED 2:01 P.M.

DEC 05 1994

LENAWEE COUNTY
 JEANETTE D. Y'NOX
 REGISTER OF DEEDS

Register of Deeds Stamp & File Number

4. Lot No. _____, Recorded Plat _____
 5. Private Claims _____

	A	B	C	D	E	F	G	H	I	J	K	L	M
1								●					
2	6	5	4	3	2	1							
3													
4	7	8	9	10	11	12							
5													
6	18	17	16	15	14	13							
7													
8	19	20	21	22	23	24							
9													
10	30	29	28	27	26	25							
11													
12	31	32	33	34	35	36							
13													

I, Glenn E. Richard, in a field survey on October 7 19 94, do hereby certify that under requirements of P.A. 74, Michigan P.A. of 1970, the corner points mentioned in lines 1 and 2 above were in conformance with regulations and rules therefore as required in the current manual of survey instructions of the United States Department of the Interior, Bureau of Land Management or by a decree of a Court of Law and/or that the corner points mentioned in lines 3, 4 and 5 above were in conformance with the rules of the Michigan Board of Land Surveyors or by a Decree of a Court of Law; established, re-established, monumented, re-monumented, recovered, found as expressed below:

NOTE: Not more than 4 corners, all in the same town and range, may be recorded on this certificate.

A. Description of original monument and accessories and/or subsequent restoration:


Corner was not set on G.L.O. Survey.
 The section was subdivided around 1840 as shown on a survey in the Satterthwaite book.
 Survey by W.E. Frazier in 1947 calls for spike.
 Survey by W.E. Frazier in 1958, found the spike when surveying some lots south on Mill Highway. These same lots were later platted as "Plat of Quaker Fancy" in November 1967.
 1967, I set iron pipe by re-tracing the Plat of Quaker Fancy and on the south line of Section 34, T5S-R4E.
 K.L. Suydam found iron pipe and recorded it in February 1976 in L. 3, P. 384, Hydrant N 69° W 31.51

B. Description of corner evidence found and/or method applied in restoring or reestablishing corner:

September 21, 1994, Found iron capped W.F.A. 17636 in monument box.
 October 7, 1994, ran line between G & H-13, T5S-R4E, and found iron capped W.F.A. 17636 to be 0.12 North of the line and 0.11 East of record distance from H-13, T5S-R4E.
 Set 3/4" X 4' iron pipe on line between G & H-13, T5S-R4E and at record distance measured in 1967 which also checked the angle measured in 1967 and the distance to the hydrant.

C. Description of monument for corner and accessories established to perpetuate locating the position of the corner:

3/4" X 4' iron pipe capped G.E.R., P.S. 13040 in monument box this position not established by original government surveyors. This monument is accepted as the best available evidence of the position of the corner.
 Top nut of hydrant N 25° W 31.51
 Dbl. hd. nail & disc in Elec. Pole N 70° W 37.16
 Dbl. hd. nail & disc in Elec. Pole N 50° E 46.64
 Dbl. hd. nail & disc in Tel. Pole S 40° E 59.14
 S 1/4 cor, Sec. 34, T5S-R4E, East 333.67

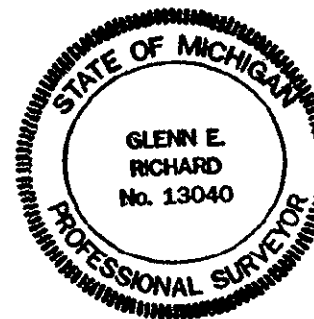

Ratified by Peer Group in accordance with P.A. 345 Co. Rep. Glenn E. Richard Date November 3, 1994
 Signed by Glenn E. Richard Date Nov. 11, 1994
 Glenn E. Richard
 Surveyor's Michigan License No. 13040