REMONUMENTATION

OCT 21 1997

COMMISSION

Filed under Remonumentation Act 345 of 1990

LAND CORNER RECORDATION CERTIFICATE

Filing Requirement of Act 74, Mich. P.A. 1970

LIBER 1 PAGE 192

For corners in
Lenawee (County)

	Located In:	Corner Code #
1. Public Land Survey	T-6-S R-4-E	M-9
	T R	
	T R	
	T R	
2. Property Controlling	S T R	
in Section	S T R	
3. Miscellaneous	S T R	
Property in Sec	S T R	

STATE OF MICHIGAN
LENAWEE COUNTY
FILED

9 OCT 97 3:39 P.M.

VICTORIA J. DANIELS
REGISTER OF DEEDS

Register of Deeds Stamp & File Number

4. Lot No. _____, Recorded Plat _____
5. Private Claims _____

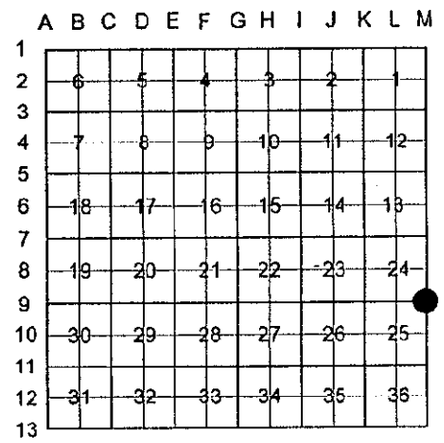

I, Glenn E. Richard, in a field survey on June 23, 19 97, do hereby certify that under requirements of P.A. 74, Michigan P.A. of 1970, the corner points mentioned in lines 1 and 2 above were in conformance with regulations and rules therefore as required in the current manual of survey instructions of the United States Department of the Interior, Bureau of Land Management or by a decree of a Court of Law and/or that the corner points mentioned in lines 3, 4 and 5 above were in conformance with the rules of the Michigan Board of Land Surveyors or by a Decree of a Court of Law; established, re-established, monumented, re-monumented, recovered, found as expressed below:

NOTE: Not more than 4 corners, all in the same town and range, may be recorded on this certificate.

A. Description of original monument and accessories and/or subsequent restoration:

G.L.O. June 1819 Joseph Fletcher D.S. set post cor Sections 24 &25 B. Ash 4 N 70 W 8 - W. Ash 8 N 24 E 9
Oct. 1841 Section 24 & May 1843 Section 25 were subdivided by S.C. Boughton, County Surveyor (monuments were not described)
J.L. Richard records from early 1900's have no record of corner except it is 11 lks north of stone at SW corner of Section 19 T6S R5E
Walter Frazier (no date) set spike in the pavement 7.3 north of SW corner of Sec 19 T6S R5E which he determined from the witnesses for SW corner of Sec 19 T6S R5E
Jan. 26, 1967 W.E. Sommer found spike set by W.E. Frazier & set spike 7.3 south for SW corner Sec 19 T6S R5E
Oct. 4 1984 I found a 1/2 iron rod (top of spike?) and recorded it in L 5 P 124
July 30, 1993 Set 3/4" X 3' iron pipe in base course of asphalt by retracing surveys from the east and west that were tied to it before everything was destroyed during road reconstruction about four years ago.

B. Description of corner evidence found and/or method applied in restoring or reestablishing corner:

June 23, 1997 I found the iron pipe as set July 30, 1993 under newly laid asphalt pavement and set monument box.

C. Description of monument for corner and accessories established to perpetuate locating the position of the corner:

3/4" X 3' iron pipe capped G.E.R. P.S. 13040 in monument box and is accepted as the best available evidence of the position of the original corner.

SW corner of Sec 19-6-5 South 7.30
"X" cut on CMP N 80° E 46.53
"X" cut on CMP S 20° E 41.32
dbl. hd. nail & disc in E.P. S 40° W 41.84
dbl. hd. nail & disc in Guy Pole N 45° W 29.68
dbl. hd. nail & disc in T.P. N 5° W 19.62
Iron pipe North 25.70

STATE OF MICHIGAN
GLENN E. RICHARD
No. 13040
PROFESSIONAL SURVEYOR

Ratified by Peer Group in accordance with P.A. 345 Co. Rep. Glenn E. Richard Date Sept. 9, 1997

Signed by Glenn E. Richard Date Sept. 19, 1997
Glenn E. Richard

Surveyor's Michigan License No. 13040

FORM APPROVED BY MICHIGAN STATE BOARD OF LAND SURVEYORS, JAN. 28, 1971
REVISED MAY 14, 1975
REVISED JAN., 1983
ADAPTED FOR WORD PROCESSING MARCH, 1993