

**SURVEY &
REMONUMENTATION**

Filed under Remonumentation Act 345 of 1990

APR 28 1995

LAND CORNER RECORDATION CERTIFICATE

Filing Requirement of Act 74, Mich. P.A. 1970

LIBER **001** PAGE **51**

COMMISSION

For corners in

Lenawee
(County)

Located In:

Corner Code #

- | | | |
|------------------------------------|---------------------------|-------------|
| 1. Public Land Survey | T <u>6</u> S R <u>5</u> E | <u>F-11</u> |
| | T _____ R _____ | _____ |
| | T _____ R _____ | _____ |
| | T _____ R _____ | _____ |
| 2. Property Controlling in Section | S _____ T _____ R _____ | _____ |
| | S _____ T _____ R _____ | _____ |
| 3. Miscellaneous Property in Sec. | S _____ T _____ R _____ | _____ |
| | S _____ T _____ R _____ | _____ |

FILED

DEC 05 1994 2:01 P.M.

LENAWEE COUNTY
JEANETTE D. F'NOX
REGISTER OF DEEDS

Register of Deeds Stamp & File Number

4. Lot No. _____, Recorded Plat _____
5. Private Claims _____

I, Glenn E. Richard, in a field survey on October 20 1994, do hereby certify that under requirements of P.A. 74, Michigan P.A. of 1970, the corner points mentioned in lines 1 and 2 above were in conformance with regulations and rules therefore as required in the current manual of survey instructions of the United States Department of the Interior, Bureau of Land Management or by a decree of a Court of Law and/or that the corner points mentioned in lines 3, 4 and 5 above were in conformance with the rules of the Michigan Board of Land Surveyors or by a Decree of a Court of Law; established, re-established, monumented, re-monumented, recovered, found as expressed below:

	A	B	C	D	E	F	G	H	I	J	K	L	M
1													
2	6	5	4	3	2	1							
3													
4	7	8	9	10	11	12							
5													
6	18	17	16	15	14	13							
7													
8	19	20	21	22	23	24							
9													
10	30	29	28	27	26	25							
11													
12	31	32	33	34	35	36							
13													

NOTE: Not more than 4 corners, all in the same town and range, may be recorded on this certificate.

A. Description of original monument and accessories and/or subsequent restoration:


G.L.O. August 1819, Joseph Fletcher set 1/4 post in plains, no bearing trees.
1881 James Blair found stake and added bricks.
December 12, 1966, I dug and found dark spot in sub soil and added iron pipe.
September 11, 1973, W.E. Sommer found 1/2" iron pipe and recorded it in L.2, P. 499, P.K. nail and disc in post North 28.19

B. Description of corner evidence found and/or method applied in restoring or reestablishing corner:

June 1994, Found 1/2" iron pipe at South edge of road.
October 20, 1994, Replaced iron pipe with 30" Harrison monument stamped P.S. 13040.

C. Description of monument for corner and accessories established to perpetuate locating the position of the corner:

30" Harrison monument stamped P.S. 13040 and is the best available evidence of the position of the original corner.
SE Cor. of brick house N 80° W 586.00
Dbl. hd. nail & disc in 28" Oak North 396.52
Fd. P.K. nail in post North 28.28
SW corner, Sec. 28, West 2628.05
SE. corner Sec. 28, East 2649.72

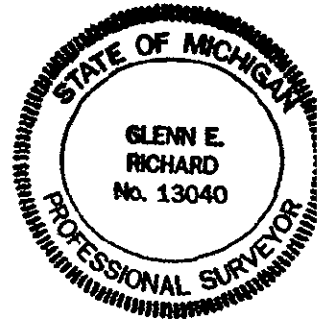

Ratified by Peer Group in accordance with P.A. 345 Co. Rep. Glenn E. Richard Date November 3, 1994
Signed by Glenn E. Richard Date Nov. 11, 1994
Glenn E. Richard

Surveyor's Michigan License No. 13040