SURVEY & REMONUMENTATION

APR 28 1995

COMMISSION

Filed under Remonumentation Act 345 of 1990

LAND CORNER RECORDATION CERTIFICATE

Filing Requirement of Act 74, Mich. P.A. 1970

LIBER 001 PAGE 52

For corners in

Lenawee (County)

	Located In:	Corner Code #
1. Public Land Survey	T-6-S R-5-E	G-11
	T___ R___	
	T___ R___	
	T___ R___	
2. Property Controlling	S___ T___ R___	
in Section	S___ T___ R___	
3. Miscellaneous	S___ T___ R___	
Property in Sec.	S___ T___ R___	

FILED

DEC 05 1994 2:01 P.M.

LENAWEE COUNTY
JEANETTE D. KNOX
REGISTER OF DEEDS

Register of Deeds Stamp & File Number

4. Lot No. _____, Recorded Plat _____
5. Private Claims _____

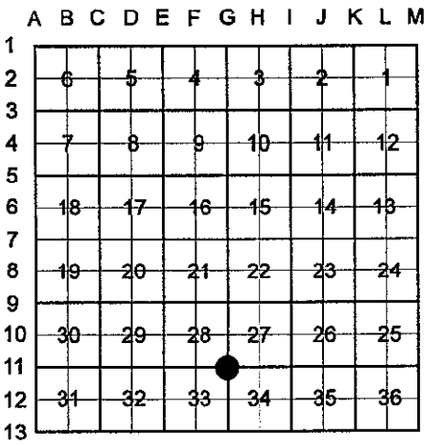

I, Glenn E. Richard, in a field survey on October 21, 1994, do hereby certify that under requirements of P.A. 74, Michigan P.A. of 1970, the corner points mentioned in lines 1 and 2 above were in conformance with regulations and rules therefore as required in the current manual of survey instructions of the United States Department of the Interior, Bureau of Land Management or by a decree of a Court of Law and/or that the corner points mentioned in lines 3, 4 and 5 above were in conformance with the rules of the Michigan Board of Land Surveyors or by a Decree of a Court of Law; established, re-established, monumented, re-monumented, recovered, found as expressed below:

NOTE: Not more than 4 corners, all in the same town and range, may be recorded on this certificate.

A. Description of original monument and accessories and/or subsequent restoration:

G.L.O. August 1819, Joseph Fletcher set post, no bearing trees being in plains.
August 1881, this corner was re-established by James Blair "Set stake & bricks on testimony of Joseph Leonard".
September 1915, J.L. Richard found old iron, drove in gas pipe SE. Cor. Section 2.7 South of road center line.
December 12, 1966, I dug through the pavement and found iron pipe which checked old record distances of J.L.Richard from the South and West.

B. Description of corner evidence found and/or method applied in restoring or reestablishing corner:

June 9, 1994, found iron pipe.
October 21, 1994, Found 1/2" X 12" iron pipe inside 1" iron pipe 16" deep and small stone. Also found tapered iron pin 1" to 1 1/4" X 6", 2 feet deep next to the 1" X 17" iron pipe. Set 30" Harrison monument stamped P.S. 13040, Corner is 5' South of the road center line.

C. Description of monument for corner and accessories established to perpetuate locating the position of the corner:

30" Harrison monument stamped P.S. 13040 and is accepted as the best available evidence of the position of the original corner.
Cut "X" on C.M.P. S 75° W 74.48
SW. corner of Tel. Pedestal North 25.16
Most easterly corner of concrete bridge deck S 85° E 95.52
Most westerly corner of concrete bridge deck S 10° E 93.98

STATE OF MICHIGAN
GLENN E. RICHARD
No. 13040
PROFESSIONAL SURVEYOR

Ratified by Peer Group in accordance with P.A. 345 Co. Rep. Glenn E. Richard Date November 3, 1994

Signed by Glenn E. Richard Date Nov. 11, 1994
Glenn E. Richard

Surveyor's Michigan License No. 13040

FORM APPROVED BY MICHIGAN STATE BOARD OF LAND SURVEYORS, JAN. 28, 19

REVISED MAY 14, 1
REVISED JAN., 1
ADAPTED FOR WORD PROCESSING MARCH, 1