

APR 01 1996

LAND CORNER RECORDATION CERTIFICATE

LIBER 001 PAGE 81

Filing Requirement of Act 74, Mich. P.A. 1970

COMMISSION

For corners in

<u>Lenawee</u>	Located in:	Corner Code #
(County)		
1. Public Land Survey	T - 6 - S R - 5 - E	G-13
	T _____ R _____	_____
	T _____ R _____	_____
	T _____ R _____	_____
2. Property Controlling	S _____ T _____ R _____	_____
in Section	S _____ T _____ R _____	_____
3. Miscellaneous	S _____ T _____ R _____	_____
Property in Sec.	S _____ T _____ R _____	_____

FILED
 NOV 22 1995 11:56 A.M.
 LENAWEE COUNTY
 JEANETTE D. KNOX
 REGISTER OF DEEDS
 Register of Deeds Stamp & File Number

- 4. Lot No. _____, Recorded Plat _____
- 5. Private Claims _____

	A	B	C	D	E	F	G	H	I	J	K	L	M
1													
2	6	5	4	3	2	1							
3													
4	7	8	9	10	11	12							
5													
6	18	17	16	15	14	13							
7													
8	19	20	21	22	23	24							
9													
10	30	29	28	27	26	25							
11													
12	31	32	33	34	35	36							
13													


I, Glenn E. Richard, in a field survey on October 4 1995, do hereby certify that under requirements of P.A. 74, Michigan P.A. of 1970, the corner points mentioned in lines 1 and 2 above were in conformance with regulations and rules therefore as required in the current manual of survey instructions of the United States Department of the Interior, Bureau of Land Management or by a decree of a Court of Law and/or that the corner points mentioned in lines 3, 4 and 5 above were in conformance with the rules of the Michigan Board of Land Surveyors or by a Decree of a Court of Law, established, re-established, monumented, re-monumented, recovered, found as expressed below:

NOTE: Not more than 4 corners, all in the same town and range, may be recorded on this certificate.

A. Description of original monument and accessories and/or subsequent restoration:
 G.L.O. 1815, Alex Holmes set post corner Section 33 & 34, Lynn 12 S 80 W 18, Lynn 6 N 80 E 14 December 1884, James Blair found "a very old stake and placed a tile over it" 1907, J.L. Richard found stake and tile.
 Feb. 1970, I dug through the pavement and found wood stake and tile and added an iron pipe and monument box.
 Nov. 1975, Found iron pipe in monument box and recorded it in L.3, P. 342.
 Sept. 1993, The Lenawee County Road Commission scarified the road and graded out the monument box. I found part of the iron pipe and replaced it with a 1/2" X 24" iron pipe.

B. Description of corner evidence found and/or method applied in restoring or reestablishing corner:
 October 4, 1995, Found the iron pipe inside of tile. Replaced it with a 30" Harrison Monument stamped P.S. 13040

C. Description of monument for corner and accessories established to perpetuate locating the position of the corner:
 30" Harrison monument stamped P.S. 13040 and is accepted as the best available evidence of the position of the original corner.
 SE. corner of house foundation N 30° W 296.40
 SW. corner of house foundation N 70° E 153.82
 Dbl. hd. nail & disc in 46" Maple S 80° E 92.72
 Dbl. hd. nail & disc in Elec. pole North 155.12
 S. 1/4 corner Section 33 West 2644.16

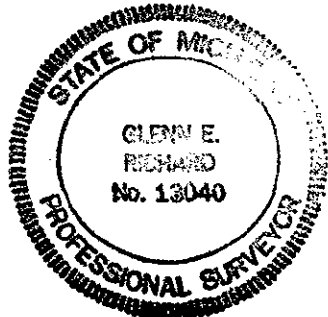

Ratified by Peer Group in accordance with P.A. 345 Co. Rep. Glenn E. Richard Date 10 - 19 - 95
 Signed by Glenn E. Richard Date Nov. 3, 1995
 Surveyor's Michigan License No. 13040