

SURVEY & REMONUMENTATION

Filed under Remonumentation Act 345 of 1990

APR 28 1995

LAND CORNER RECORDATION CERTIFICATE

LIBER 001 PAGE 53

Filing Requirement of Act 74, Mich. P.A. 1970

COMMISSION

For corners in

Lenawee
(County)

Located In:

Corner Code #

- 1. Public Land Survey T - 6 - S R - 5 - E 1-10
 T _____ R _____
 T _____ R _____
 T _____ R _____
- 2. Property Controlling S _____ T _____ R _____
 in Section S _____ T _____ R _____
- 3. Miscellaneous S _____ T _____ R _____
 Property in Sec. S _____ T _____ R _____

FILED

DEC 05 1994 2:01 P.M.

LENAWEE COUNTY
JEANETTE D. INOX
REGISTER OF DEEDS

Register of Deeds Stamp & File Number

- 4. Lot No. _____, Recorded Plat _____
- 5. Private Claims _____

	A	B	C	D	E	F	G	H	I	J	K	L	M
1													
2	6	5	4	3	2	1							
3													
4	7	8	9	10	11	12							
5													
6	18	17	16	15	14	13							
7													
8	19	20	21	22	23	24							
9													
10	30	29	28	27	26	25							
11													
12	31	32	33	34	35	36							
13													

I, Glenn E. Richard, in a field survey on October 21, 1994, do hereby certify that under requirements of P.A. 74, Michigan P.A. of 1970, the corner points mentioned in lines 1 and 2 above were in conformance with regulations and rules therefore as required in the current manual of survey instructions of the United States Department of the Interior, Bureau of Land Management or by a decree of a Court of Law and/or that the corner points mentioned in lines 3, 4 and 5 above were in conformance with the rules of the Michigan Board of Land Surveyors or by a Decree of a Court of Law; established, re-established, monumented, re-monumented, recovered, found as expressed below:

NOTE: Not more than 4 corners, all in the same town and range, may be recorded on this certificate.

A. Description of original monument and accessories and/or subsequent restoration:


G.L.O. August 1819, Joseph Fletcher set post, no bearing trees being in plains.
 August 30, 1881, James Blair re-established the corner and set stake and bricks.
 August 15, 1974, I found remains of stake, bricks and stone, added 3/4" X 4' iron pipe and recorded it in L.3, P. 33, 60d spike in 24" Maple SW 29.53

B. Description of corner evidence found and/or method applied in restoring or reestablishing corner:

October 21, 1994, Found 3/4" iron pipe. Replaced iron pipe with 30" Harrison monument stamped P.S. 13040. In the process I found several bricks, remains of wood stake and had to chip off part of the stone to get the Harrison monument set.

C. Description of monument for corner and accessories established to perpetuate locating the position of the corner:

30" Harrison monument stamped P.S. 13040 and is accepted as the best available evidence of the position of the original corner.
 60d spike in east face 26" Maple S 30° W 29.46
 Dbl. hd. nail & disc in west face Elec.pole N 10° E 172.62
 Dbl. hd. nail & disc in west face Elec pole S 10° E 245.99
 NW Cor. conc. block found. of old house S 10° W 424.43

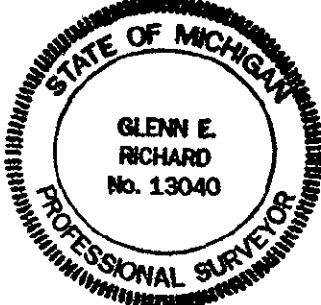

Ratified by Peer Group in accordance with P.A. 345 Co. Rep. Glenn E. Richard Date November 3, 1994
 Signed by Glenn E. Richard Date Nov. 11, 1994
 Surveyor's Michigan License No. 13040