

**SURVEY &
REMONUMENTATION**

APR 28 1995

COMMISSION

Filed under Remonumentation Act 345 of 1990

LAND CORNER RECORDATION CERTIFICATE

Filing Requirement of Act 74, Mich. P.A. 1970

LIBER **001** PAGE **54**

For corners in

Lenawee
(County)

Located In:

Corner Code #

- 1. Public Land Survey T 6-S R 5-E 1-11
 T _____ R _____
 T _____ R _____
 T _____ R _____
- 2. Property Controlling S _____ T _____ R _____
 in Section S _____ T _____ R _____
- 3. Miscellaneous S _____ T _____ R _____
 Property in Sec. S _____ T _____ R _____

FILED

DEC 05 1994 2:01 P.M.

LENAWEE COUNTY
JEANETTE D. INOX
REGISTER OF DEEDS

Register of Deeds Stamp & File Number

- 4. Lot No. _____, Recorded Plat _____
- 5. Private Claims _____

	A	B	C	D	E	F	G	H	I	J	K	L	M
1													
2	6	5	4	3	2	1							
3													
4	7	8	9	10	11	12							
5													
6	18	17	16	15	14	13							
7													
8	19	20	21	22	23	24							
9													
10	30	29	28	27	26	25							
11													
12	31	32	33	34	35	36							
13													

I, Glenn E. Richard, in a field survey on October 24, 1994, do hereby certify that under requirements of P.A. 74, Michigan P.A. of 1970, the corner points mentioned in lines 1 and 2 above were in conformance with regulations and rules therefore as required in the current manual of survey instructions of the United States Department of the Interior, Bureau of Land Management or by a decree of a Court of Law and/or that the corner points mentioned in lines 3, 4 and 5 above were in conformance with the rules of the Michigan Board of Land Surveyors or by a Decree of a Court of Law; established, re-established, monumented, re-monumented, recovered, found as expressed below:

NOTE: Not more than 4 corners, all in the same town and range, may be recorded on this certificate.

A. Description of original monument and accessories and/or subsequent restoration:


G.L.O. August 1819, Joseph Fletcher set post, B. Ash 10 S 58 E 15
 September 10, 1881, James Blair "Found corner standing old stake" B. Ash 12 S 56° E 53 links
 September 28, 1915, J.L. Richard found large stone.
 August 13, 1974, I dug and found large stone over iron bar, raised it to the surface with an iron pipe and recorded it in L. 3, P. 33, Fd. nail & washer in Pole N 55° E 32.77
 Fd. nail & washer in Elec. Pole S 30° E 41.16

B. Description of corner evidence found and/or method applied in restoring or reestablishing corner:

October 24, 1994, dug through pavement and found iron pipe 8" deep. Replaced it with 3/4" X 3' iron pipe capped P.S. 13040 in monument box.

C. Description of monument for corner and accessories established to perpetuate locating the position of the corner:

3/4" X 3' iron pipe capped G.E.R., P.S. 13040 and is accepted as the best available evidence of the position of the original corner.
 Cut "X" on C.M.P. S 65° W 38.56
 Cut "X" on C.M.P. N 45° W 25.16
 Fd. nail & washer in SE. face of pole (top cut off) N 55° E 32.83
 Fd. nail & washer in west face of Elec. pole S 30° E 41.14

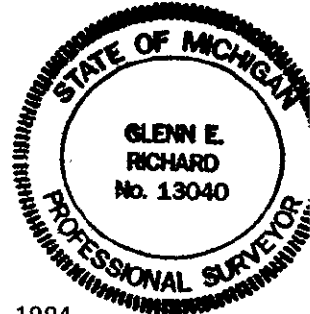

Ratified by Peer Group in accordance with P.A. 345 Co. Rep. Glenn E. Richard Date November 3, 1994
 Signed by Glenn E. Richard Date Nov. 11, 1994
 Glenn E. Richard

Surveyor's Michigan License No. 13040