

JAN 13 2000

SECTION

Filed under Remonumentation Act 345 of 1990  
LIBER 1 PAGE 385  
LAND CORNER RECORDATION CERTIFICATE  
Filing Requirement of Act 74, Mich. P.A. 1970

STATE OF MICHIGAN  
LENAWEE COUNTY  
FILED

14 DEC 1999 4:32:19 PM

For corners in

Lenawee (County)	Located In:	Corner Code #
1. Public Land Survey	T - 7 - S R - 3 - E	B-7
	T _____ R _____	_____
	T _____ R _____	_____
	T _____ R _____	_____
2. Property Controlling in Section	S _____ T _____ R _____	_____
	S _____ T _____ R _____	_____
3. Miscellaneous Property in Sec	S _____ T _____ R _____	_____
	S _____ T _____ R _____	_____

VICTORIA J. DANIELS  
REGISTER OF DEEDS

Register of Deeds Stamp & File Number

- 4. Lot No. \_\_\_\_\_ Recorded Plat \_\_\_\_\_
- 5. Private Claims \_\_\_\_\_

	A	B	C	D	E	F	G	H	I	J	K	L	M
1													
2	6	5	4	3	2	1							
3													
4	7	8	9	10	11	12							
5													
6	18	17	16	15	14	13							
7	●												
8	19	20	21	22	23	24							
9													
10	30	29	28	27	26	25							
11													
12	31	32	33	34	35	36							
13													

I, Glenn E. Richard, in a field survey on November 22, 1999, do hereby certify that under requirements of P.A. 74, Michigan P.A. of 1970, the corner points mentioned in lines 1 and 2 above were in conformance with regulations and rules therefore as required in the current manual of survey instructions of the United States Department of the Interior, Bureau of Land Management or by a decree of a Court of Law and/or that the corner points mentioned in lines 3, 4 and 5 above were in conformance with the rules of the Michigan Board of Land Surveyors or by a Decree of a Court of Law; established, re-established, monumented, re-monumented, recovered, found as expressed below:

NOTE: Not more than 4 corners, all in the same town and range, may be recorded on this certificate.

A. Description of original monument and accessories and/or subsequent restoration:

GLO 1824 John Mullett set 1/4 Sec. post Whitewood 15 N 42 E 18 Whitewood 18 S 32 E 13  
 Couldn't find any information on this corner in any of the old survey records  
 1943 Walter Frazier did a survey along the east line of the West 1/2, NE 1/4, Section 19. His notes don't show what was found or set.  
 1956 Werner Sommer while employed by Walter Frazier did a lot survey west of this corner but didn't re-establish the corner. He used the NE corner of Section 19 2870.45 feet East for the point of beginning.  
 1970 Werner Sommer re-established the NE corner of the W 1/2, NE 1/4 of Sec. 19 by retracing the 1943 Walter Frazier survey and his 1956 survey and set a iron pipe.  
 1973 Werner Sommer extended the line west at double the distance between the NE corner of the W 1/2, NE 1/4 and the NE cor. Sec. 19 and set a R.R. spike for the 1/4 corner common to sections 18 and 19  
 1976 Kenneth Suydam used this for the point of beginning for Plat of Kings Cove No. 2, recorded in Liber 18, Pages 21 & 22  
 1977 Kenneth Suydam found iron pipe? and recorded it in Liber 4 Page 14 with the same witnesses taken by Werner Sommer when he set the R.R. spike


B. Description of corner evidence found and/or method applied in restoring or reestablishing corner:

November 22, 1999 Found R.R. spike under base course of new asphalt pavement. Replaced it with 5/8" X 3' re-rod with Lenawee County Re-mon cap stamped P.S. 13040 and set monument box.

C. Description of monument for corner and accessories established to perpetuate locating the position of the corner:

5/8" X 3' re-rod with Lenawee County re-mon cap P.S. 13040 in monument box and is accepted as the best available evidence of the position of the original corner

Survey mark spike & re-mon tag in E.P. S 5° E 60.78  
 "X" cut on top of concrete drive culvert N 60° E 35.34  
 N.W. corner of Hse. #4477 foundation S 65° W 131.90  
 N.E. corner of Hse. #4477 foundation S 40° W 185.23

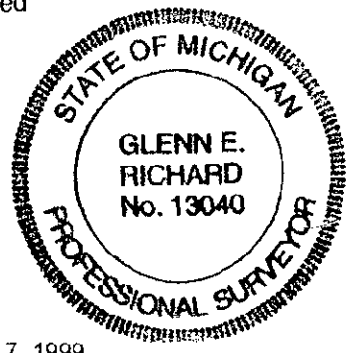

Ratified by Peer Group in accordance with P.A. 345 Co. Rep. Glenn E. Richard Date December 7, 1999

Signed by Glenn E. Richard Date Dec. 8, 1999  
Glenn E. Richard

Surveyor's Michigan License No. 13040