

JAN 18 2000

SECTION

Filed under Remonumentation Act 345 of 1990

LAND CORNER RECORDATION CERTIFICATE

LIBER 1

PAGE 387

Filing Requirement of Act 74, Mich. P.A. 1970

STATE OF MICHIGAN  
LENAWEE COUNTY  
FILED

For corners in

Lenawee (County)	Located In:	Corner Code #
1. Public Land Survey	T - 7 - S R - 3 - E	C-7
	T R	
	T R	
	T R	
2. Property Controlling in Section	S T R	
	S T R	
3. Miscellaneous Property in Sec	S T R	
	S T R	

14 DEC 1999 4:32:45 PM

VICTORIA J. DANIELS  
REGISTER OF DEEDS

Register of Deeds Stamp & File Number

- 4. Lot No. \_\_\_\_\_, Recorded Plat \_\_\_\_\_
- 5. Private Claims \_\_\_\_\_

I, Glenn E. Richard, in a field survey on November 11, 1999, do hereby certify that under requirements of P.A. 74, Michigan P.A. of 1970, the corner points mentioned in lines 1 and 2 above were in conformance with regulations and rules therefore as required in the current manual of survey instructions of the United States Department of the Interior, Bureau of Land Management or by a decree of a Court of Law and/or that the corner points mentioned in lines 3, 4 and 5 above were in conformance with the rules of the Michigan Board of Land Surveyors or by a Decree of a Court of Law; established, re-established, monumented, re-monumented, recovered, found as expressed below:

	A	B	C	D	E	F	G	H	I	J	K	L	M
1													
2	6	5	4	3	2	1							
3													
4	7	8	9	10	11	12							
5													
6	18	17	16	15	14	13							
7													
8	19	20	21	22	23	24							
9													
10	30	29	28	27	26	25							
11													
12	31	32	33	34	35	36							
13													

NOTE: Not more than 4 corners, all in the same town and range, may be recorded on this certificate.

A. Description of original monument and accessories and/or subsequent restoration:

GLO 1824 John Mullett set post corner Sec.'s 17, 18, 19 & 20 Whitewood 10 S 56 E 13 W. Oak 36 N 35 W 36  
 Couldn't find any information on this corner in any of the old survey records  
 1950 I worked on a survey crew with Kenneth Suydam while employed by Walter Frazier and we set a iron pipe in line with fence South  
 1956 Werner Sommer while employed by Walter Frazier did a lot survey 2870 feet west of this corner. His notes show "NE corner Sec. 19. Found iron set by Marino?"  
 1970 Werner Sommer found square bolt  
 1971 Werner Sommer used this corner for point of beginning for Plat of Kings Cove No. 1 recorded in Liber 17 Pages 14 & 15  
 1977 Werner Sommer found square iron bar & recorded it in Liber 4, Page 35  
 1988 I found square iron


B. Description of corner evidence found and/or method applied in restoring or reestablishing corner:

November 11, 1999 I dug through base course of new asphalt & found square drag tooth in original pavement. Dug further and found split seam iron pipe 0.40 N and 0.40 E of the drag tooth location. I retraced the point of beginning of the Plat of Kings Cove No. 1 and it checked to the found drag tooth. All survey records that I could find were tied to the drag tooth, I replaced it with a 5/8" X 3' re-rod with Lenawee County Re-mon cap stamped P.S. 13040 and a monument box.

C. Description of monument for corner and accessories established to perpetuate locating the position of the corner:

5/8" X 3' re-rod with Lenawee County re-mon cap P.S. 13040 in monument box and is accepted as the best available evidence of the position of the original corner

Replaced fd nail & ribbon with dbl hd nail & re-mon tag in E.P. N 65° E 63.46  
 Fd. nail & disc in E.P. S 70° E 65.56  
 North Face of steel post South 29.95  
 NE corner of old brick school house S 45° W 79.75

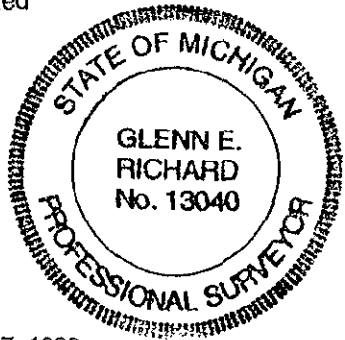

Ratified by Peer Group in accordance with P.A. 345 Co. Rep. Glenn E. Richard Date December 7, 1999

Signed by Glenn E. Richard Date Dec. 8, 1999  
 Glenn E. Richard

Surveyor's Michigan License No. 13040