Filed under Remonumentation Act 345 of 1990

LAND CORNER RECORDATION CERTIFICATE

Filing Requirement of Act 74, Mich. P.A. 1970

LIBER 001 PAGE 117

STATE OF MICHIGAN
LENAWEE COUNTY
FILED

13 NOV 96 9:03 A.M.

JEANETTE D. KNOX
REGISTER OF DEEDS

Register of Deeds Stamp & File Number

For corners in Lenawee (County)

	Located In:	Corner Code #
1. Public Land Survey	T-7-S R-4-E	A-3
	T___ R___	
	T___ R___	
	T___ R___	
2. Property Controlling	S___ T___ R___	
in Section	S___ T___ R___	
3. Miscellaneous	S___ T___ R___	
Property in Sec	S___ T___ R___	

4. Lot No. _____, Recorded Plat _____
5. Private Claims _____

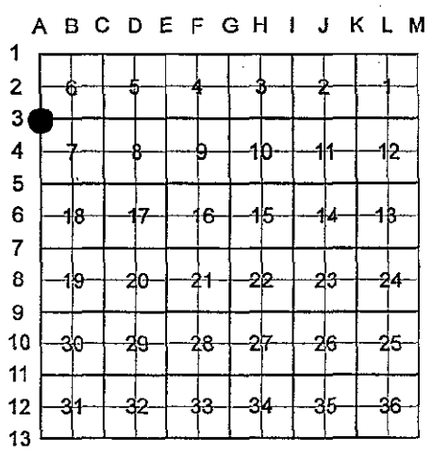

I, Glenn E. Richard, in a field survey on October 17 19 96, do hereby certify that under requirements of P.A. 74, Michigan P.A. of 1970, the corner points mentioned in lines 1 and 2 above were in conformance with regulations and rules therefore as required in the current manual of survey instructions of the United States Department of the Interior, Bureau of Land Management or by a decree of a Court of Law and/or that the corner points mentioned in lines 3, 4 and 5 above were in conformance with the rules of the Michigan Board of Land Surveyors or by a Decree of a Court of Law; established, re-established, monumented, re-monumented, recovered, found as expressed below:

NOTE: Not more than 4 corners, all in the same town and range, may be recorded on this certificate.

A. Description of original monument and accessories and/or subsequent restoration:

GLO 1819, Joseph Fletcher, intersect W. Bdy. 40 lks. North of post, Set post at intersection Cor. Sec. 6 & 7, Hickory 8 N 40 W 17, Hickory 10 S 80 E 48
James Blair records show in 1876 B. Kent surveyed the SE 1/4 of Sec. 1, T7S-R3E and shows the jog to be 41 ilnks (No description of monumentation).
James Blair and J.L. Richard records show 41 links (No description of monumentation)
1974 through 1990 A.E.S. found nail and disc and used it on several surveys.
1974 George Warnke used the nail & disc.
1976 K.L. Suydam recorded it in L. 3, P. 386
1991 Pete Beaver shows the corner on a survey (No witnesses or monumentation)
October 1993, The Lenawee County Road Commission rebuilt the bridge and cut the intersection down 4'± and filled it back with sand. They set an iron pipe in a monument box from witnesses taken prior to construction.

B. Description of corner evidence found and/or method applied in restoring or reestablishing corner:

September 26, 1996, Found iron pipe in monument box, 27.13 North of M-3, T7S-R3E.
October 17, 1996, Removed F.I.P. and set 3/4" X 3' gas pipe 27.06 on the town line north of peer group approved location for M-3, T7S-R3E.

C. Description of monument for corner and accessories established to perpetuate locating the position of the corner:

3/4" X 3' gas pipe capped G.E.R. 13040 in monument box and is accepted as the best available evidence of the position of the original corner.
SW. corner of concrete bridge rail N 40° E 32.09
SE. corner of concrete bridge rail N 30° W 38.24
Fd. nail & D. Erickson tag in Elec. pole S 81° E 86.03
Fd. dbl. head nail in Elec. pole S 25° E 79.25
Set dbl. head nail & Re-mon. tag in Elec. pole S 30° W 98.87
Fd. nail & D. Erickson tag in Elec. pole N 80° W 43.64
3/4" X 3' gas pipe in monument box M-3, T7S-R3E, South 27.06

STATE OF MICHIGAN
GLENN E. RICHARD
No: 13040
PROFESSIONAL SURVEYOR

Ratified by Peer Group in accordance with P.A. 345 Co. Rep. Glenn E. Richard Date October 8, 1996

Signed by Glenn E. Richard Date 10-29-96
Glenn E. Richard

Surveyor's Michigan License No. 13040

FORM APPROVED BY MICHIGAN STATE BOARD OF LAND SURVEYORS, JAN. 28, 19

REVISED MAY 14, 19
REVISED JAN., 19
ADAPTED FOR WORD PROCESSING MARCH, 19