JAN 2 5 2000

SECTION

Filed under Remonumentation Act 345 of 1990

LAND CORNER RECORDATION CERTIFICATE

Filing Requirement of Act 74, Mich. P.A. 1970 LIBER 1 PAGE 382

STATE OF MICHIGAN
LENAWEE COUNTY
FILED

7 DEC 1999 1:05:14 PM

VICTORIA J. DANIELS
REGISTER OF DEEDS

Register of Deeds Stamp & File Number

For corners in Lenawee (County)

	Located In:	Corner Code #
1. Public Land Survey	T-7-S R-4-E	E-12
	T___ R___	
	T___ R___	
	T___ R___	
2. Property Controlling in Section	S___ T___ R___	
	S___ T___ R___	
3. Miscellaneous Property in Sec	S___ T___ R___	
	S___ T___ R___	

4. Lot No. _____, Recorded Plat _____
5. Private Claims _____

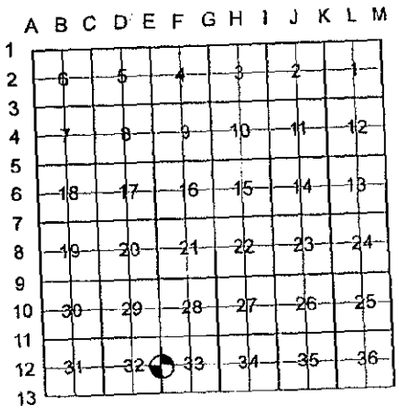

I, Glenn E. Richard, in a field survey on October 5, 1999, do hereby certify that under requirements of P.A. 74, Michigan P.A. of 1970, the corner points mentioned in lines 1 and 2 above were in conformance with regulations and rules therefore as required in the current manual of survey instructions of the United States Department of the Interior, Bureau of Land Management or by a decree of a Court of Law and/or that the corner points mentioned in lines 3, 4 and 5 above were in conformance with the rules of the Michigan Board of Land Surveyors or by a Decree of a Court of Law; established, re-established, monumented, re-monumented, recovered, found as expressed below:

NOTE: Not more than 4 corners, all in the same town and range, may be recorded on this certificate.

A. Description of original monument and accessories and/or subsequent restoration:

GLO 1819 Joseph Fletcher set 1/4 Sec. post Maple 10 N 5 Elm 6 N 43 E 6
1863 James Blair's record "Found stake and added stone and bricks
1886 James Blair
1891 James Blair found stake, stone & bricks.
1972 Kenneth Suydam set iron pipe
1978 I found an iron pipe in the pavement and recorded it in Liber 4, Page 192
1984 I found iron pipe
1998 I found an iron pipe and took witnesses prior to road reconstruction

B. Description of corner evidence found and/or method applied in restoring or reestablishing corner:

Oct. 5, 1999 Iron pipe removed during road reconstruction. Dug hole and probed but found nothing. Set 5/8" X 3' re-rod with Lenawee County Re-mon cap stamped P.S. 13040 from witnesses taken in 1998.
Oct. 8, 1999 Set monument box in new asphalt pavement.

C. Description of monument for corner and accessories established to perpetuate locating the position of the corner:

5/8" X 3' re-rod with Lenawee County Re-mon cap stamped P.S. 13040 in a monument box and is accepted as the best available evidence of the position of the original corner.

Survey mark spike & re-mon tag in E.P. N 5° W 31.40
"X" on CMP N 15° E 39.08
"X" on CMP S 70° E 57.76
Re-rod capped GER on Section line South 44.25

STATE OF MICHIGAN
GLENN E. RICHARD
No. 13040
PROFESSIONAL SURVEYOR

Ratified by Peer Group in accordance with P.A. 345 Co. Rep. Glenn E. Richard Date November 23, 1999

Signed by Glenn E. Richard Date Dec. 1, 1999
Glenn E. Richard

Surveyor's Michigan License No. 13040

FORM APPROVED BY MICHIGAN STATE BOARD OF LAND SURVEYORS, JAN. 28, 1971
REVISED MAY 14, 1975
REVISED JAN., 1983
ADAPTED FOR WORD PROCESSING MARCH, 1993