

**SURVEY &  
REMONUMENTATION**

APR 28 1995

COMMISSION

Filed under Remonumentation Act 345 of 1990

LAND CORNER RECORDATION CERTIFICATE

Filing Requirement of Act 74, Mich. P.A. 1970

LIBER 001 PAGE 37

For corners in

Lenawee  
(County)

Located In:

Corner Code #

- |                                    |                                   |            |
|------------------------------------|-----------------------------------|------------|
| 1. Public Land Survey              | T <u>7</u> - S <u>4</u> R - 4 - E | <u>G-3</u> |
|                                    | T _____ R _____                   | _____      |
|                                    | T _____ R _____                   | _____      |
|                                    | T _____ R _____                   | _____      |
| 2. Property Controlling in Section | S _____ T _____ R _____           | _____      |
|                                    | S _____ T _____ R _____           | _____      |
| 3. Miscellaneous Property in Sec.  | S _____ T _____ R _____           | _____      |
|                                    | S _____ T _____ R _____           | _____      |

**FILED**

DEC 05 1994 2:01 pm

LENAWEE COUNTY  
JEANETTE D. KNOX  
REGISTER OF DEEDS

Register of Deeds Stamp & File Number

4. Lot No. \_\_\_\_\_, Recorded Plat \_\_\_\_\_  
5. Private Claims \_\_\_\_\_

I, Glenn E. Richard, in a field survey on November 14 1994, do hereby certify that under requirements of P.A. 74, Michigan P.A. of 1970, the corner points mentioned in lines 1 and 2 above were in conformance with regulations and rules therefore as required in the current manual of survey instructions of the United States Department of the Interior, Bureau of Land Management or by a decree of a Court of Law and/or that the corner points mentioned in lines 3, 4 and 5 above were in conformance with the rules of the Michigan Board of Land Surveyors or by a Decree of a Court of Law; established, re-established, monumented, re-monumented, recovered, found as expressed below:

	A	B	C	D	E	F	G	H	I	J	K	L	M
1													
2	6	5	4	3	2	1							
3													
4	7	8	9	10	11	12							
5													
6	18	17	16	15	14	13							
7													
8	19	20	21	22	23	24							
9													
10	30	29	28	27	26	25							
11													
12	31	32	33	34	35	36							
13													

**NOTE: Not more than 4 corners, all in the same town and range, may be recorded on this certificate.**

A. Description of original monument and accessories and/or subsequent restoration:


G.L.O. July 1819, Joseph Fletcher set post corner Sec. 3, 4, 9 & 10, Sugar 12 N 75 E 8, Ironwood 6 N 2 E 17  
April 1882, James Blair found old stake 1 1/2' East of west RR. fence and North from ditch.  
January 1908, J.L. Richard, R.L.S. 171, records called for iron bar about 2 1/4 lks East of West RR. fence.  
November 7, 1969, I found strap iron.  
June 7, 1977, K.L. Suydam found "iron strap" and recorded it in L. 4, P. 7, West guage of RR. East 10.85

B. Description of corner evidence found and/or method applied in restoring or reestablishing corner:

November 14, 1994, found strap iron using previous surveys and distance from west RR. guage (10.85)  
Replaced strap iron with 30" Harrison monument and marked with carsonite sign post.

C. Description of monument for corner and accessories established to perpetuate locating the position of the corner:

30" Harrison monument marked with a carsonite sign post and is accepted as the best available evidence of the position of the original corner.  
West guage of RR. track East 10.85  
3/8" rod in road pavement West 33.00  
Cut "X" on North end 12" C.M.P. N 20° W 48.60  
Cut "X" on West end 24" cast iron culvert S 10° E 9.62

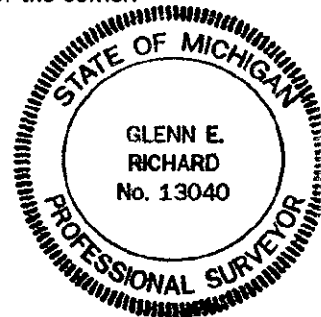

Ratified by Peer Group in accordance with P.A. 345 Co. Rep. Glenn E. Richard Date November 17, 1994  
Signed by Glenn E. Richard Date Nov. 25, 1994  
Glenn E. Richard  
Surveyor's Michigan License No. 13040